

5.097-20040-0000

STATE OF KANSAS
STATE CORPORATION COMMISSION


Form CP-4

WELL PLUGGING RECORD

Give All Information Completely
Make Required Affidavit
Mail or Deliver Report to:
Conservation Division
State Corporation Commission
212 No. Market
Wichita, Kansas

Edwards County. Sec. 15 Twp. 26S Rge. (E) 19W (W)

Location as "NE/CNW/SW" or footage from lines C SW SE
Lease Owner Glen N. Rupe
Lease Name Craft Well No. 1
Office Address 222 Brown Bldg. Wichita, Kansas
Character of Well (completed as Oil, Gas or Dry Hole) Dry Hole
Date well completed 10-24 1968
Application for plugging filed 10-24 1968
Application for plugging approved 10-24 1968
Plugging commenced 10-24 1968
Plugging completed 10-24 1968
Reason for abandonment of well or producing formation Dry Hole

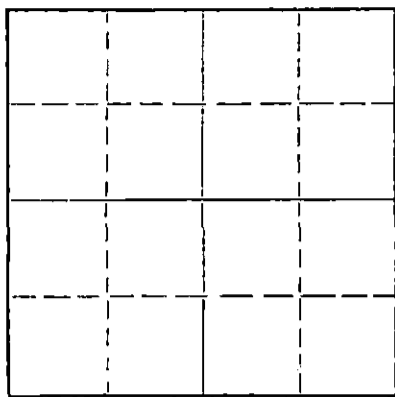

Locate well correctly on above Section Plat

If a producing well is abandoned, date of last production 19
Was permission obtained from the Conservation Division or its agents before plugging was commenced? Yes

Name of Conservation Agent who supervised plugging of this well Ralph Warren
Producing formation Depth to top Bottom Total Depth of Well 4764 Feet
Show depth and thickness of all water, oil and gas formations.

OIL, GAS OR WATER RECORDS

CASING RECORD

FORMATION	CONTENT	FROM	TO	SIZE	PUT IN	PULLED OUT
				8 5/8"	250'	none

Describe in detail the manner in which the well was plugged, indicating where the mud fluid was placed and the method or methods used in introducing it into the hole. If cement or other plugs were used, state the character of same and depth placed, from feet to feet for each plug set.

Plugged with 50 sacks common cement @ 600'
Plugged with 25 sacks common cement @ 240'
Plugged with 10 sacks Common cement @ 40'
Two sacks common in rathole

RECEIVED
STATE CORPORATION COMMISSION
OCT 29 1968
CONSERVATION DIVISION
Wichita, Kansas

(If additional description is necessary, use BACK of this sheet)
Name of Plugging Contractor Leben Drilling, Inc.
Address Box 486, Great Bend, Kansas

STATE OF KANSAS, COUNTY OF BARTON, ss.
Leslie Kite (employee of owner) or (owner or operator) of the above-described well, being first duly sworn on oath, says: That I have knowledge of the facts, statements, and matters herein contained and the log of the above-described well as filed and that the same are true and correct. So help me God.

(Signature) Leslie Kite

(Address)

SUBSCRIBED AND SWORN TO before me this 28th day of October, 1968

My commission expires April 1, 1971
Ulanda Nichols Notary Public.

DRILLER'S LOG

15-047-20040-0000

COMPANY
CONTRACTOR
FARM
LOCATION

COMMENCED
COMPLETED

Glen N. Rupe
LEBEN DRILLING, INC.
Craft #1
C SW SE SECTION 15-26S-19W
EDWARDS COUNTY, KANSAS
10-14-68
10-24-68

0	131	Surface Sand
131	209	Sand
209	250	Shale
250	1200	Shale, Red Bed
1200	1306	Shale, Shells
1306	1324	Anhydrite
1324	2000	Shale, Shells
2000	2150	Shale
2150	2580	Lime, Shale
2580	2885	Lime
2885	3014	Lime, Shale
3014	3500	Shale, Lime
3500	4155	Lime, Shale
4155	4670	Lime
4670	4764	Lime, Chert
	<u>4764</u>	<u>RTD - D. & A.</u>

RECEIVED
STATE CORPORATION COMMISSION
OCT 29 1968
CONSERVATION DIVISION
Wichita, Kansas

8 5/8" 20# surface casing set @ 250' cemented with 250 sacks Common
2% cc

I, Leslie Kite, do hereby certify that the above and foregoing is
a true and correct copy of the log of the Craft #1 Well, located
C SW SE of Section 15, Township 26 South, Range 19 West, Edwards
County, Kansas, as reflected by the records of Leben Drilling, Inc.

Leslie Kite

Leslie Kite

STATE OF KANSAS)
) SS
COUNTY OF BARTON)

Subscribed and sworn to and before me, a Notary Public, in
and for Barton County, Kansas, this 28th day of October, 1968.

Ulanda Nichols

Ulanda Nichols

My Commission Expires:
April 1, 1971