


WELL PLUGGING RECORD 15-047-0229-00-01

Give All Information Completely  
Make Required Affidavit  
Mail or Deliver Report to:  
Conservation Division  
State Corporation Commission  
212 No. Market  
Wichita, Kansas

NORTH

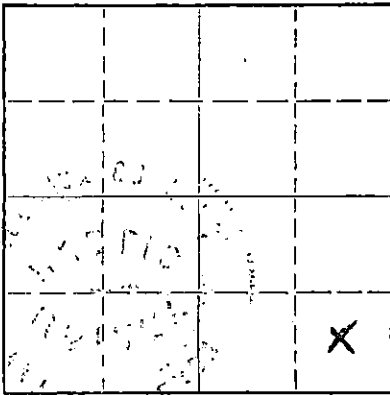

Locate well correctly on above Section Plat

Edwards County, Sec. 26 Twp. 26 Rge. 19 (E) W (W)  
Location as "NE/CNW/SW" or footage from lines C SE SE  
Lease Owner Glen Rupe  
Lease Name King "OWING" Well No. B #1  
Office Address 222 Brown Bldg. Wichita, Kansas 67202  
Character of Well (completed as Oil, Gas or Dry Hole) \_\_\_\_\_  
Date well completed \_\_\_\_\_ 19\_\_\_\_  
Application for plugging filed October 1969  
Application for plugging approved October 1969  
Plugging commenced November 7 1969  
Plugging completed November 13 1969  
Reason for abandonment of well or producing formation \_\_\_\_\_

If a producing well is abandoned, date of last production \_\_\_\_\_ 19\_\_\_\_  
Was permission obtained from the Conservation Division or its agents before plugging was commenced? Yes

Name of Conservation Agent who supervised plugging of this well Ralph Warren  
Producing formation \_\_\_\_\_ Depth to top \_\_\_\_\_ Bottom \_\_\_\_\_ Total Depth of Well \_\_\_\_\_ Feet  
Show depth and thickness of all water, oil and gas formations.

OIL, GAS OR WATER RECORDS

CASING RECORD

FORMATION	CONTENT	FROM	TO	SIZE	PUT IN	PULLED OUT
				8 5/8	320	None
				5 1/2	4385	2503

Describe in detail the manner in which the well was plugged, indicating where the mud fluid was placed and the method or methods used in introducing it into the hole. If cement or other plugs were used, state the character of same and depth placed, from \_\_\_\_\_ feet to \_\_\_\_\_ feet for each plug set.

November 7, 1969 Plugged off bottom. Dumped sand to 4700'. Mixed and dumped 5 sx of cement.

November 13, 1969 Set 10' rock bridge from 260' to 250'. Mixed and dumped 25 sx of cement. Mudded casing to 40'. Set 10' rock bridge from 40' to 30'. Mixed and dumped 10 sx of cement from 30' to base of cellar.

RECEIVED  
STATE CORPORATION COMMISSION  
DEC 19 1969  
CONSERVATION DIVISION  
Wichita, Kansas

(If additional description is necessary, use BACK of this sheet)  
Name of Plugging Contractor Russ Casing Pulling, Inc.  
Address P. O. Box 1082 Great Bend, Kansas 67530

STATE OF Kansas, COUNTY OF Sedgwick, ss.  
Glen Rupe (employee of owner) or (owner) or operator of the above-described well, being first duly sworn on oath, says: That I have knowledge of the facts, statements, and matters herein contained and the log of the above-described well as filed and that the same are true and correct. So help me God.

(Signature) Glen Rupe  
222 Brown Building,  
Wichita, Kansas 67202

SUBSCRIBED AND SWORN TO before me this 20th day of November, 1969

My commission expires September 16, 1973

Faye W. Leach Notary Public.

15-047-0229-0000  
COPY


WELL LOG BUREAU—KANSAS GEOLOGICAL SOCIETY  
508 East Murdock, Wichita, Kansas

Company- PICKRELL DRILLING CO.  
Farm- King "B" No. 1

SEC. 26 T. 26 R. 19W  
C SE SE

Total Depth. 4917'  
Comm. 8-29-60 Comp. 9-16-60  
Shot or Treated.  
Contractor. Pickrell Drig.  
Issued. 10-15-60

County Edwards  
KANSAS

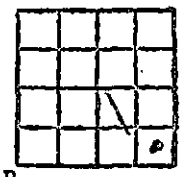

Elevation. 2221' RB

Production. Dry

Figures Indicate Bottom of Formations.

Meas. from top of RB.

sand	150
blue shale	330
shale	530
red bed	700
Blaine	715
shale, shells	965
shells, sand, shale	1165
sandy shale	1275
Anhydrite	1310
shale, shells	1970
lime, shale	2325
shale, lime	2455
lime, shale	2595
lime	3078
lime, shale	3180
lime	3240
lime, shale	3650
lime	3765
lime, shale	4360
lime	4655
lime, shale	4689
lime	4717
lime, sand	4746
Mississippi	4917
Total Depth	

TOPS: SCOUT	
Heebner	4030
Lansing	4159
Base Kansas City	4568
Marmaton	4578
Cherokee	4675
Burgess Sand	4741
Reworded Mississippi	4751
Mississippi	4758

RECEIVED  
STATE CORPORATION COMMISSION  
NOV 10 1969  
CONSERVATION DIVISION  
Wichita, Kansas