

EFFECTIVE DATE: 10-24-90

P.U

FORM MUST BE TYPED
FORM C-1 4/90

State of Kansas
NOTICE OF INTENTION TO DRILL

FORM MUST BE SIGNED
ALL BLANKS MUST BE FILLED

Must be approved by the K.C.C. five (5) days prior to commencing well

Expected Spud Date October 20, 1990
month day year

C - SE NE Sec 18 Twp 24 S, Rg 10 East West

OPERATOR: License # 30080
Name: HONEY OIL CO., INC.
Address: 401 East Douglas - Suite 505
City/State/Zip: Wichita, Kansas 67202
Contact Person: L. V. Bell
Phone: 316/265-7700

3300 feet from South (line of Section)
660 feet from East line of Section
(Note: Locate well on Section Plat on Reverse Side)

CONTRACTOR: License #: 5929
Name: RUKE DRILLING CO., INC.

County: Reno
Lease Name: Schaffin, Inc. Well #: 1
Field Name: Unknown
Is this a Prorated Field? yes X no
Target formation(s): Viola
Nearest lease or unit boundary: 660'
Ground Surface Elevation: Unknown feet MSW
Domestic well within 330 feet: yes X no
Municipal well within one mile: yes X no
Depth to bottom of fresh water: 90'
Depth to bottom of usable water: 140'
Surface Pipe by Alternate: X 1 2
Length of Surface Pipe Planned to be set: 270'
Length of Conductor pipe required: None
Projected Total Depth: 3900'
Formation at Total Depth: Viola
Water Source for Drilling Operations:
well farm pond X other
DWR Permit #: _____
Will Cores Be Taken?: yes X no
If yes, proposed zone: _____

Well Drilled For: Well Class: Type Equipment:
X Oil ... Inj ..X Infield ..X Mud Rotary
... Gas ... Storage ... Pool Ext. ... Air Rotary
... OAWO ... Disposal ... Wildcat ... Cable
... Seismic; ... # of Holes

If OAWO: old well information as follows:
Operator: _____
Well Name: _____
Comp. Date: _____ Old Total Depth _____

Directional, Deviated or Horizontal wellbore? yes X no
If yes, total depth location: _____

AFFIDAVIT

The undersigned hereby affirms that the drilling, completion and eventual plugging of this well will comply with K.S.A. 55-101, et. seq.

- It is agreed that the following minimum requirements will be met:
1. The appropriate district office shall be notified before setting surface pipe;
 2. The minimum amount of surface pipe as specified above shall be set by circulating cement to the top; in all cases surface pipe shall be set through all unconsolidated materials plus a minimum of 20 feet into the underlying formation;
 3. If the well is dry, a plugging proposal shall be submitted to the district office. An agreement between the operator and the district office on plug length and placement is necessary prior to plugging;
 4. The appropriate district office will be notified before well is either plugged or production casing is cemented in;
 5. If an Alternate II completion, production pipe shall be cemented from below any usable water to surface within 120 days of spud date. In all cases, notify district office prior to any completion.

I hereby certify that the statements made herein are true and to the best of my knowledge and belief.

Date: 10/15/90 Signature of Operator or Agent: James B. Phillips Title: Agent

FOR KCC USE:
API # 15- 155-21,146-0000
Conductor pipe required None feet
Minimum surface pipe required 100 feet per Alt. ①
Approved by: M.P.W. 10-19-90
EFFECTIVE DATE: 10-24-90
This authorization expires: 4-19-91
(This authorization void if drilling not started within 6 months of effective date.)
Spud date: _____ Agent: _____



18
24
1000
OCT 15 1990
CONSERVATION DIVISION
Wichita, Kansas
10-15-90

REMEMBER TO:

- File Drill Pit Application (form CDP-1) with Intent to Drill;
- File Completion Form ACO-1 within 120 days of spud date;
- File acreage attribution plat according to field proration orders;
- Notify appropriate district office 48 hours prior to workover or re-entry;
- Submit plugging report (CP-4) after plugging is completed;
- Obtain written approval before disposing or injecting salt water.

Mail to: Conservation Division, 200 Colorado Derby Building, 202 W. First St., Wichita, Kansas 67202-1286.


PLAT OF ACREAGE ATTRIBUTABLE TO A WELL

State Corporation Commission, Conservation Division
200 Colorado Derby Bldg. Wichita, Kansas 67202

OPERATOR HONEY OIL CO., INC. LOCATION OF WELL:
 LEASE Schaffin Inc. 3300 feet north of SE corner
 WELL NUMBER 1 660 feet west of SE corner
 FIELD Unknown NE/4 Sec. 18 T 24S R 10 E/W
 COUNTY Reno
 NO. OF ACRES ATTRIBUTABLE TO WELL 10 IS SECTION REGULAR IRREGULAR?
 DESCRIPTION OF ACREAGE NE/4 IF IRREGULAR, LOCATE WELL FROM NEAREST
 CORNER BOUNDARY.

NOTE: If plat depicted is insufficient for your circumstances, you may attach your own scaled or surveyed plat.

PLAT

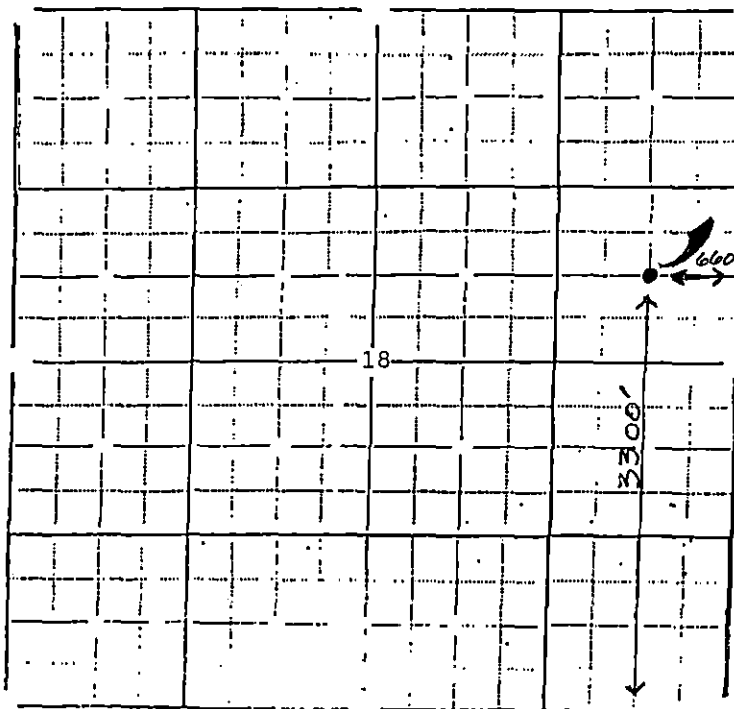

In plotting the proposed location of the well, you must show:

- 1) The manner in which you are using the depicted plat by identifying section lines, i.e.: section, section with 8 surrounding partial sections, 4 sections, 16 sections, etc.;
- 2) the well's location relative to the location of other wells producing from the same common source or supply in adjoining drilling units pursuant to K.A.R. 82-3-108, 82-3-207, 82-3-312, or special orders of the Commission;
- 3) the distance of the proposed drilling location from the section's east and south lines; and
- 4) the distance to the nearest lease or unit boundary line.

I hereby certify that the statements made hereon are true and to the best of my knowledge and belief.

Signature of Operator or Agent James J. Jones

Date 10/15/90 Title Agent