

FOR KCC USE:

FORM C-1 7/91

EFFECTIVE DATE: 1-10-2001
DISTRICT # 2
SGA? Yes No

State of Kansas
NOTICE OF INTENTION TO DRILL

FORM MUST BE TYPED
FORM MUST BE SIGNED
ALL BLANKS MUST BE FILLED

Must be approved by the K.C.C. five (5) days prior to commencing well.

Expected Spud Date December 10, 2000
month day year

Spot C SW SW Sec 4 Twp 24 S, Rg 10 East XX West

OPERATOR: License # 31980
Name: Lotus Operating Company, LLC
Address: 100 S. Main - Suite 520
City/State/Zip: Wichita, Kansas 67202
Contact Person: Timothy D. Hellman
Phone: (316) 262-1077

660 feet from South / WEST line of Section
660 feet from WEST / West line of Section
IS SECTION XX REGULAR IRREGULAR?

(NOTE: Locate well on the Section Plat on Reverse Side)

County: Reno
Lease Name: Hurst Well #: 1
Field Name: Wildcat

CONTRACTOR: License #: 5929
Name: Duke Drilling Co., Inc.

Is this a Prorated/Spaced Field? XX yes no
Target Formation(s): Mississippi

Nearest lease or unit boundary: 660'
Ground Surface Elevation: 1787 feet MSL

Well Drilled For: Well Class: Type Equipment:
... Oil ... Enh Rec ... Infield XX Mud Rotary
... Gas ... Storage ... Pool Ext. ... Air Rotary
XX OWWD ... Disposal XX Wildcat ... Cable
... Seismic; ... # of Holes ... Other
... Other

Water well within one-quarter mile: X yes XX no
Public water supply well within one mile: XX yes no

Depth to bottom of fresh water: 250
Depth to bottom of usable water: 250

Surface Pipe by Alternate: XX 1
Length of Surface Pipe Planned to be set: 8-5/8" @ .297' w/

If OWWD: old well information as follows:
Operator: Honey Oil Co.
Well Name: #1 Hurst
Comp. Date: 6/01/90 Old Total Depth 4015'

Length of Conductor pipe required: 160 sx
Projected Total Depth: 4015'

Formation at Total Depth: Simpson Sand
Water Source for Drilling Operations:

... well XX farm pond XX other

Directional, Deviated or Horizontal wellbore? XX yes no
If yes, true vertical depth:
Bottom Hole Location:

Will Cores Be Taken?: XX yes no
If yes, proposed zone:

AFFIDAVIT

The undersigned hereby affirms that the drilling, completion and eventual plugging of this well will comply with K.S.A. 55-101, et. seq.

It is agreed that the following minimum requirements will be met:

1. Notify the appropriate district office prior to spudding of well;
2. A copy of the approved notice of intent to drill shall be posted on each drilling rig;
3. The minimum amount of surface pipe as specified below shall be set by circulating cement to the top; in all cases surface pipe shall be set through all unconsolidated materials plus a minimum of 20 feet into the underlying formation;
4. If the well is dry hole, an agreement between the operator and the district office on plug length and placement is necessary prior to plugging;
5. The appropriate district office will be notified before well is either plugged or production casing is cemented in;
6. IF AN ALTERNATE II COMPLETION, PRODUCTION PIPE SHALL BE CEMENTED FROM BELOW ANY USABLE WATER TO SURFACE WITHIN 120 DAYS OF SPUD DATE. IN ALL CASES, NOTIFY DISTRICT OFFICE PRIOR TO ANY CEMENTING.

I hereby certify that the statements made herein are true and to the best of my knowledge and belief.

Date: 9/05/00 Signature of Operator or Agent: Timothy D. Hellman Title: Managing Member

RECEIVED
KANSAS CORPORATION COMMISSION

SEP 06 2000
9-6-00
CONSERVATION DIVISION
WICHITA, KS

FOR KCC USE: API # 15- 155-21135-0001
Conductor pipe required NONE feet
Minimum surface pipe required 297 feet per Alt (1)
Approved by: JK 1-5-2001
This authorization expires: 7-5-2001
(This authorization void if drilling not started within 6 months of effective date.)
Spud date: _____ Agent: _____

REMEMBER TO:

- File Drill Pit Application (form CDP-1) with Intent to Drill;
- File Completion Form ACO-1 within 120 days of spud date;
- File acreage attribution plat according to field proration orders;
- Notify appropriate district office 48 hours prior to workover or re-entry;
- Submit plugging report (CP-4) after plugging is completed;
- Obtain written approval before disposing or injecting salt water.

Mail to: KCC - Conservation Division, 130 S. Market - Room 2078, Wichita, Kansas 67202.

4
24
101

IN ALL CASES PLOT THE INTENDED WELL ON THE PLAT BELOW

PLAT OF ACREAGE ATTRIBUTABLE TO A WELL IN A PRORATED OR SPACED FIELD

If the intended well is in a prorated or spaced field, please fully complete this side of the form. If the intended well is in a prorated or spaced field complete the plat below showing that the well will be properly located in relationship to other wells producing from the common source of supply. Please show all the wells within 1 mile of the boundaries of the proposed acreage attribution unit for gas wells and within 1/2 mile of the boundaries of the proposed acreage attribution unit for oil wells.



API NO. 15- _____
 OPERATOR Lotus Operating Co. LLC LOCATION OF WELL: COUNTY Reno
 LEASE Hurst 660' feet from south/~~XXXX~~ line of section
 WELL NUMBER #1 660 feet from ~~XXXX~~/west line of section
 FIELD Wildcat SECTION 4 TWP 24S RG 10W

NUMBER OF ACRES ATTRIBUTABLE TO WELL 40 IS SECTION XX REGULAR or _____ IRREGULAR
 QTR/QTR/QTR OF ACREAGE C - SW - SW IF SECTION IS IRREGULAR, LOCATE WELL FROM NEAREST CORNER BOUNDARY.

Section corner used: _____ NE _____ NW _____ SE _____ SW

PLAT

(Show location of the well and shade attributable acreage for prorated or spaced wells.)
 (Show footage to the nearest lease or unit boundary line.)

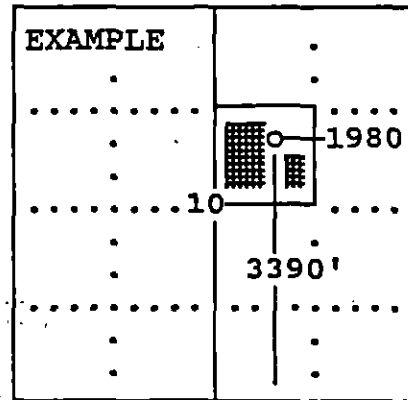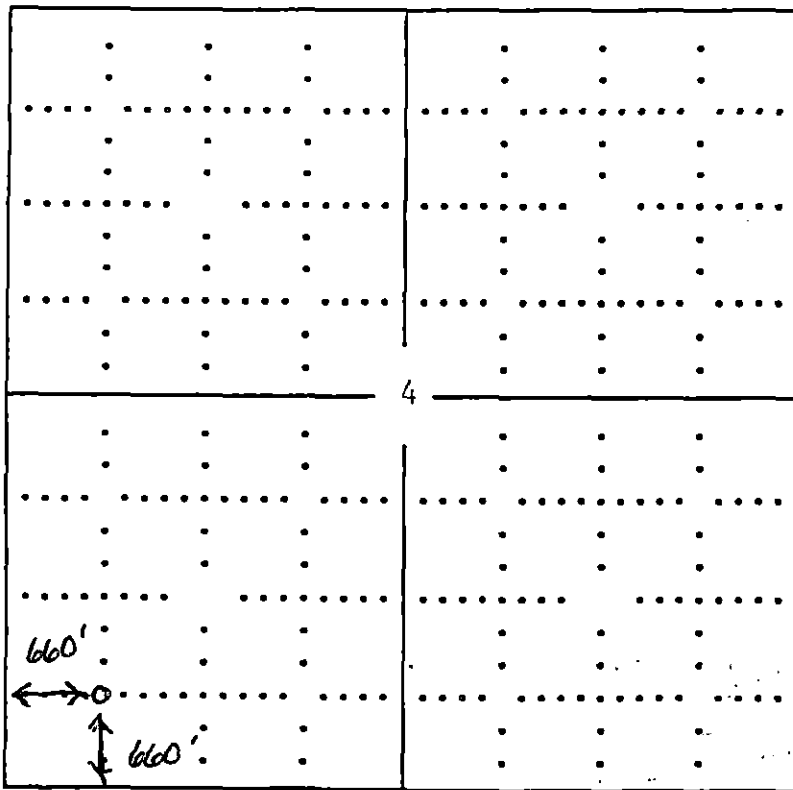

SEWARD CO.

In plotting the proposed location of the well, you must show:

- 1) The manner in which you are using the depicted plat by identifying section lines, i.e. 1 section, 1 section with 8 surrounding sections, 4 sections, etc.;
- 2) the distance of the proposed drilling location from the section's south/north and east/west; and
- 3) the distance to the nearest lease or unit boundary line.