


WELL PLUGGING RECORD

Give All Information Completely
Make Required Affidavit
Mail or Deliver Report to:
Conservation Division
State Corporation Commission
212 No. Market
Wichita, Kansas

NORTH

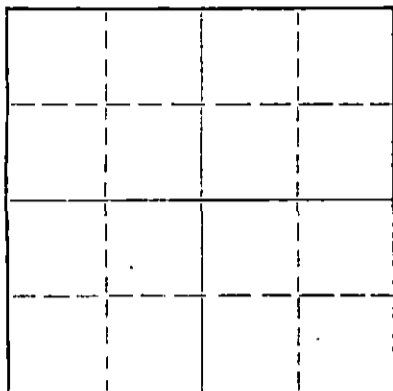

Locate well correctly on above
Section Plat

Reno County. Sec. 7 Twp. 22S Rge. 4 (W)

Location as "NE/CNW/SW" or footage from lines NW NW SW

Lease Owner Osage Oil & Gas Company, Inc.

Lease Name Unruh Well No. 1

Office Address 302 Petroleum Building, Wichita, Kansas

Character of Well (completed as Oil, Gas or Dry Hole) Dry Hole

Date well completed 9-7- 1957

Application for plugging filed 9-7- 1957

Application for plugging approved 9-7- 1957

Plugging commenced 9-7- 1957

Plugging completed 9-7- 1957

Reason for abandonment of well or producing formation Dry Hole

If a producing well is abandoned, date of last production 19

Was permission obtained from the Conservation Division or its agents before plugging was commenced? Yes

Name of Conservation Agent who supervised plugging of this well Ruel Durkee

Producing formation _____ Depth to top _____ Bottom _____ Total Depth of Well 3892 Feet

Show depth and thickness of all water, oil and gas formations.

OIL, GAS OR WATER RECORDS

CASING RECORD

FORMATION	CONTENT	FROM	TO	SIZE	PUT IN	PULLED OUT
				8 5/8"	277'	0

Describe in detail the manner in which the well was plugged, indicating where the mud fluid was placed and the method or methods used in introducing it into the hole. If cement or other plugs were used, state the character of same and depth placed, from _____ feet to _____ feet for each plug set.

Gunned pits and circulated; hole made solid at 260 feet. Dumped 15 sacks of cement thru 8 joints of drill pipe; Mudded hole to 25 feet; set bridge with 5 sacks of cement at top.

RECEIVED
STATE CORPORATION COMMISSION

AUG 30 1966

8-30-66

(If additional description is necessary, use BACK of this sheet)

Name of Plugging Contractor Hilton Drilling Company, Inc.,

Address Great Bend, Kansas

STATE OF _____, COUNTY OF _____, ss.

_____(employee of owner) or (owner or operator) of the above-described well, being first duly sworn on oath, says: That I have knowledge of the facts, statements, and matters herein contained and the log of the above-described well as filed and that the same are true and correct. So help me God.

(Signature) Donald F. Moore

SUBSCRIBED AND SWORN TO before me this 30th day of August, 1966

My commission expires 11-5-67

Edward S. Greider
Notary Public.

DRILLER'S LOG

COMPANY: OSAGE OIL & GAS COMPANY, INC. LOCATION: NW NW SW
 SECTION 7-22S-14W
 CONTRACTORS: HILTON DRILLING COMPANY, INC. RENO COUNTY, KANSAS
 FARM NAME: URRUH No. 1 ELEVATION: 1486 DF
 COMMENCED: 8-24-57 CASING USED: 8 5/8" @ 277' w/175 sx.
 COMPLETED: 9-8-57

SURFACE CLAY AND SHALE	75
SHALE AND SHELLS	675
LIME AND SHALE	2250
LIME	2355
LIME AND SHALE	2679
LIME	3168
LIME AND SHALE	3341
LIME	3388
LIME AND CHERT	3666
SHALE AND LIME	3724
SAND AND LIME	3751
LIME AND SHALE	3859
LIME AND SAND	3876
SAND	3890
TOTAL DEPTH	3972

STATE OF KANSAS)
) ss.
 COUNTY OF BARTON)

I, THE UNDERSIGNED, BEING DULY SWORN ON OATH, STATE THAT THE ABOVE STATEMENT AND LOG ARE TRUE AND A CORRECT RECORD AND LOG OF THE WELL DRILLED AT THE LOCATION ABOVE DESCRIBED.

HILTON DRILLING COMPANY, INC.

Jack L. Craft
 JACK CRAFT, SECRETARY

SUBSCRIBED AND SWORN TO BEFORE ME THIS 13TH DAY OF SEPTEMBER, 1957.

Mildred Hobbie
 NOTARY PUBLIC

MILDRED HOBBIIE,
 MY COMMISSION EXPIRES MARCH 6, 1958

RECEIVED
 STATE CORPORATION COMMISSION
 APR 28 1958

PLUGGING
 FILE SEC 7 T. 22 R. 14W
 BOOK PAGE 44 LINE 15

4-28-58

OSAGE OIL & GAS CO., INC.
WICHITA, KANSAS

DETACH AND RETAIN THIS STATEMENT
THE ATTACHED CHECK IS IN PAYMENT OF ITEMS DESCRIBED BELOW.
IF NOT CORRECT PLEASE NOTIFY US PROMPTLY. NO RECEIPT DESIRED.

Vos. #7-8-052 & 7-8-057

Plugging Fees- Hall #1 & Unruh #1

10-26-57