


STATE OF KANSAS
STATE CORPORATION COMMISSION

WELL PLUGGING RECORD

Give All Information Completely
Make Required Affidavit
Mail or Deliver Report to
Conservation Division
State Corporation Comm.
245 North Water
Wichita, KS 67202

Reno County, Sec. 7 Twp. 22S Rge. 4 ~~SW~~W
Location as "NE/CNW $\frac{1}{2}$ SW $\frac{1}{2}$ " or footage from lines
N/2 SE SW

Lease Owner Pendleton Land & Exploration, Inc.
Lease Name Janzen-Lewis Unit Well No. #1
Office Address 23 Inverness Way East, Englewood, Colo. 80112
Character of Well (Completed as Oil, Gas or Dry Hole)

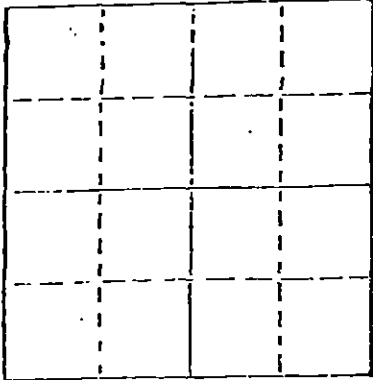

Locate well correctly on above
Section Plat

Dry Hole
Date Well completed 7-28-81 19
Application for plugging filed 7-28-81 19
Application for plugging approved 7-28-81 19
Plugging commenced 7-28-81 19
Plugging completed 7-28-81 19

Reason for abandonment of well or producing formation
Commercial quantities of oil not found
If a producing well is abandoned, date of last production 19.

Was permission obtained from the Conservation Division or
its agents before plugging was commenced? Yes

Name of Conservation Agent who supervised plugging of this well Gilbert Tolman
Producing formation Depth to top Bottom Total Depth of Well 3930'
Show depth and thickness of all water, oil and gas formations.

OIL, GAS OR WATER RECORDS

CASING RECORD

FORMATION	CONTENT	FROM	TO	SIZE	PUT IN	PULLED OUT
				8 5/8"	280'	None

Describe in detail the manner in which the well was plugged, indicating where the mud fluid
was placed and the method or methods used in introducing it into the hold. If cement or other
plugs were used, state the character of same and depth placed, from feet to
feet for each plug set.

Plug @ 310' w/50 sx.
Plug @ 40' w/10 sx.
Rat Hole 10 sx.

(If additional description is necessary, use BACK of this sheet)

Name of Plugging Contractor Silverado Drilling, Inc.

RECEIVED
STATE CORPORATION COMMISSION

150244001

8-24-81


STATE OF Kansas COUNTY OF Sedgwick CONSERVATION DIVISION
Joseph B. Brungardt, Jr., Acct. of Silverado Drilling, (employee of owner or operator)
of the above-described well, being first duly sworn on oath, says: That I have knowledge of
the facts, statements, and matters herein contained and the log of the above-described well
as filed and that the same are true and correct. So help me God.

(Signature) *Joseph B. Brungardt, Jr.*
435 Page Court, 220 W. Douglas, Wichita, Ks. 67202
(Address)

SUBSCRIBED AND SWORN TO before me this 10 day of August, 1981

Juanita M. Green
Juanita M. Green (Notary Public.)

My commission expires 10-4-83

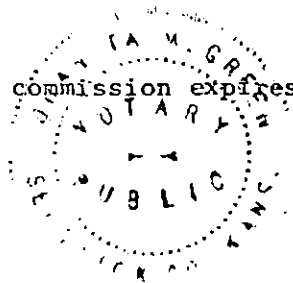

DRILLER'S LOG

COMPANY: Pendleton Land & Exploration, Inc.

SEC. 7 T. 22S R. 4W

WELL NAME: Janzen-Lewis Unit #1

LOC. N/2 SE SW

COUNTY: Reno

RIG NO. #10

TOTAL DEPTH 3930'

ELEVATION 1486' GR
1491' KB

COMMENCED: 7-11-81

COMPLETED: 7-28-81

CONTRACTOR: Silverado Drilling, Inc.

CASING RECORD:

SURFACE: 10 3/4" @ 280' w/250 sx. common, 2% cc.

PRODUCTION: D&A

LOG

(Figures Indicate Bottom of Formations)

Sand & Shale	682
Shale & Sand	970
Lime & Shale	2355
Lime	3165
Lime & Shale	3264
Shale & Lime	3762
Lime	3852
Lime & Shale	3896
Shale & Lime	3930
<u>ROTARY TOTAL DEPTH</u>	<u>3930</u>

RECEIVED
STATE CORPORATION COMMISSION

AUG 24 1981
8-24-81
CONSERVATION DIVISION
Wichita, Kansas

STATE OF Kansas)
COUNTY OF Sedgwick)

SS:

I, Joseph B. Brungardt, Jr., Acct. of Silverado Drilling Company, Inc.
upon oath state that the above and foregoing is a true and correct copy of the log of the
Janzen-Lewis Unit #1 well.

Joseph B. Brungardt, Jr.
Joseph B. Brungardt, Jr.



Subscribed and sworn to before me this 10 day of August, 1981.

My Appointment Expires:

10-4-83

Juanita M. Green
Juanita M. Green