STATE OF KANSAS
STATE CORPORATION COMMISSION
200 Colorado Derby Bldg.
Wichita, Kansas 67202


Form CP-4
Rev. 12-15-80

15-155-20893-0000

WELL PLUGGING RECORD

Give All Information Completely
Make Required Affidavit

COUNTY Reno SEC. 8 TWP. 22 RGE. 4 ~~E~~/W
Location as in quarters or footage from lines:
SE, NW, SW (1650' FSL & 990' FWL of section)

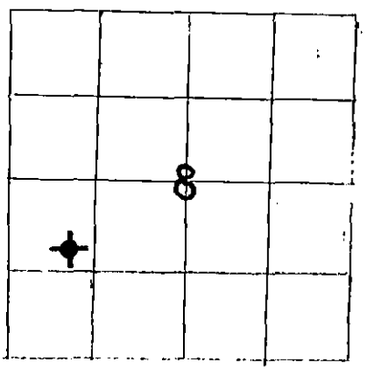

Locate Well correctly on above Section Platt.

Lease Owner R. J. Walker Oil Co., Inc.
Lease Name F. M. Goertzen Well No. 1-8
Office Address 3524 N. W. 56th Street Okla. City, OK. 73112
Character of Well (Completed as Oil, Gas or Dry Hole): Dry Hole
Date Well Completed 9-9-82
Application for plugging filed 9-9-82
Plugging commenced 9-9-82
Plugging completed 9-9-82
Reason for abandonment of well or producing formation
D & A
Was permission obtained from the Conservation Division or it's Agent's before plugging was commenced? Yes

Name of Conservation Agent who supervised plugging of this well Merlan Unruh
Producing formation NONE Depth to top bottom T.D. 4050'
Show depth and thickness of all water, oil and gas formations.

OIL, GAS OR WATER RECORDS — Casing Record

Formation	Content	From	To	Size	Put in	Pulled Out
				13 3/8"	209'	-0-
				8 5/8"	706'	-0-

Describe in detail the manner in which the well was plugged, indicating where the mud fluid was placed and the method or methods used in introducing it into the hold. If cement or other plugs were used, state the character of same and depth placed, from feet to feet for each plug set.

Plugged w/150 sax @ 900' & fluid to 260' 35 sax,
Fluid to 40', ½ sax hulls, plug, 10 sax cement
10 sax in RH & 10 sax in MH
Plugged @ 9:45 PM

(If additional description is necessary, use BACK of this sheet)
Name of Plugging Contractor Kansas Drilling & Well Service, Inc.

STATE OF Kansas COUNTY OF Marion, ss.
N. Dee McDonald (employee of owner) or (owner or operator) of the above-described well, being first duly sworn on oath, says: That I have knowledge of the facts, statements, and matters herein contained and the log of the above-described well as filed and that the same are true and correct. So help me God.

(Signature) N. Dee McDonald
Lost Springs, Ks
(Address)

SUBSCRIBED AND SWORN TO before me this 13 day of Sept, 1982

Shirley M. McDonald
Notary Public.

My Commission expires:

SHIRLEY M. McDONALD
STATE NOTARY PUBLIC
Marion County, Kansas
My Appointment Expires:
6-19-84

OCT 20 1982
10-20-82
CONSERVATION DIVISION
Wichita, Kansas

SIDE TWO

#1-8 ACO-1 WELL HISTORY

OPERATOR R. J. Walker Oil Co. Inc. LEASE F. M. Goertzen SEC. 8 TWP. 22 RGE. 4W

SE, NW, SW API #15-155-20,893-0000

FILL IN WELL LOG AS REQUIRED:

Show all important zones of porosity and contents thereof; cored intervals, and all drill-stem tests, including depth interval tested, cushion used, time tool open, flowing and shut-in pressures, and recoveries.

SHOW GEOLOGICAL MARKERS, LOGS RUN, OR OTHER DESCRIPTIVE INFORMATION.

FORMATION DESCRIPTION, CONTENTS, ETC.	TOP	BOTTOM	NAME	DEPTH
sand, shales	0	516		
shale, lime	516	2303		
shale, lime, sand	2303	2530		
Douglas	2530	2662		
Lansing	2662	3085		
K. C.	3085	3393		
Miss	3393	3440		
Miss Chat	3440	3581		
Miss Lime	3581	3670		
Kinderhook	3670	3918		
Viola	3918	3935		
Simpson	3935	4015		
Arbuckle	4015	4050		
TD	4050			
"DRILLERS LOG"				

RELEASED

SEP 01 1983

8-1-83

FROM CONFIDENTIAL

Report of all strings set — surface, intermediate, production, etc. CASING RECORD (New) or (~~Used~~)

Purpose of string	Size hole drilled	Size casing set (in O.D.)	Weight lbs/ft.	Setting depth	Type cement	Sacks	Type and percent additives
Surface #1	17 1/2"	13 3/8	68	209' KB	Cl. A Comm	200	3% CC
Surface #2	12 1/4"	8 5/8	23	706' KB	50/50 Poz	300	2% Gel 6% salt
					Cl. A Comm	75	3% CC

LINER RECORD

Top, ft.	Bottom, ft.	Sacks cement

TUBING RECORD

Size	Setting depth	Packer set at

PERFORATION RECORD

Shots per ft.	Size & type	Depth interval

ACID, FRACTURE, SHOT, CEMENT SQUEEZE RECORD

Amount and kind of material used	Depth interval treated
D X A	

Date of first production	Producing method (flowing, pumping, gas lift, etc.)	Gravity

RATE OF PRODUCTION PER 24 HOURS	Oil	Gas	Water %	Gas-oil ratio
	bbls.	MCF	bbls.	CFPB

Disposition of gas (vented, used on lease or sold) Perforations