

15-155-20423-0000

STATE OF KANSAS
STATE CORPORATION COMMISSION

WELL PLUGGING RECORD

Give All Information Completely
Make Required Affidavit
Mail or Deliver Report to
Conservation Division
State Corporation Comm.
245 North Water
Wichita, KS 67202

Reno County, Sec. 15 Twp. 22S Rge. 4W E/W
Location as "NE/CNW 1/4 SW 1/4" or footage from lines
NW SE

Lease Owner PICKRELL DRILLING COMPANY
Lease Name FRANZ "C" Well No. 1
Office Address 205 LITWIN BLDG., WICHITA, KS. 67202
Character of Well (Completed as Oil, Gas or Dry Hole)

DRY HOLE


Date Well completed 5-19-77 19
Application for plugging filed 5-19-77 19
Application for plugging approved 5-19-77 19
Plugging commenced 5-19-77 19
Plugging completed 5-19-77 19

Reason for abandonment of well or producing formation
DRY HOLE

If a producing well is abandoned, date of last production 19

Was permission obtained from the Conservation Division or its agents before plugging was commenced? Yes

Name of Conservation Agent who supervised plugging of this well Gilbert Toman
Producing formation Depth to top Bottom Total Depth of Well 3890
Show depth and thickness of all water, oil and gas formations.

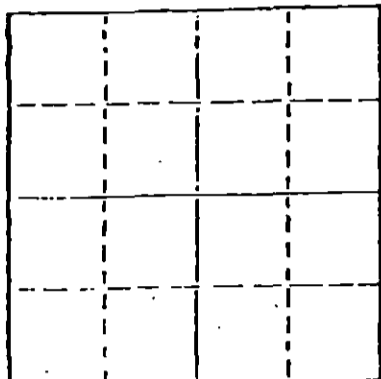

Locate well correctly on above Section Plot

OIL, GAS OR WATER RECORDS

CASING RECORD

FORMATION	CONTENT	FROM	TO	SIZE	PUT IN	PULLED OUT
				8 5/8	272	None

Describe in detail the manner in which the well was plugged, indicating where the mud fluid was placed and the method or methods used in introducing it into the hold. If cement or other plugs were used, state the character of same and depth placed, from feet to feet for each plug set.

RECEIVED
STATE CORPORATION COMMISSION
MAY 26 1977
CONSERVATION DIVISION
Wichita, KS
5-26-77

30 sacks at 300'
10 sacks at 40'
2 sacks in Rat Hole Job comp. 7PM 5-19-77

(If additional description is necessary, use BACK of this sheet)

Name of Plugging Contractor PICKRELL DRILLING COMPANY

STATE OF KANSAS COUNTY OF SEDGWICK, ss.
C. W. SEBITS (employee of owner) or (owner or operator)

of the above-described well, being first duly sworn on oath, says: That I have knowledge of the facts, statements, and matters herein contained and the log of the above-described well as filed and that the same are true and correct. So help me God, BY: C. W. SEBITS

(Signature) [Signature]
205 LITWIN BLDG., WICHITA, KS. 67202
(Address)

SUBSCRIBED AND SWORN TO before me this 25 day of May, 19 77



My commission expires

[Signature]
Jo Ann Sarver Notary Public.

ROTARY DRILLING LOG

COMPANY: PICKRELL DRILLING COMPANY
205 LITWIN BLDG.
WICHITA, KS. 67202
LOCATION: FRANZ "C" #1
NW SE Sec. 15-22S-4W
Reno Co., Ks.
CONTRACTOR: PICKRELL DRILLING COMPANY
Wichita, Kansas

Rotary Drilling Commenced 5-10-77
Rotary Drilling Completed 5-19-77

CASING RECORD: Surface casing 8 5/8" set at 272' with 165sx. comp. 5-10-77 9PM

LOG

(Figures indicate bottom of formation — measurements from top of rotary bushing.)

Top Soil & Clay	65
Sand	71
Shale	380
Shale	600
Shale & Shells	643
Shale & Sand	775
Shale & Lime	1145
Shale & Lime	1385
Lime & Shale	1580
Lime & Shale	1835
Lime & Shale	2045
Lime	2240
Lime & Shale	2365
Shale & Sand Lime	2590
Lime	2715
Lime	2845
Lime	2925
Lime	3015
Lime & Shale	3105
Lime & Shale	3175
Lime	3280
Lime & Shale	3370
Lime	3420
Lime	3532
Lime	3583
Lime	3650
Lime	3705
Shale & Lime	3755
Lime	3830
Lime	3890

RECEIVED
STATE CORPORATION COMMISSION
MAY 26 1977
5-26-77
CONSERVATION DIVISION
Wichita, Kansas

The undersigned, C. W. Sebitts, Attorney-in-Fact for PICKRELL DRILLING COMPANY, hereby certifies in behalf of said Company, that the above is a true and correct log of the formation encountered in drilling the above well as reflected by the Daily Drilling Reports.

PICKRELL DRILLING COMPANY
By [Signature]
Attorney-in-Fact
C. W. Sebitts

STATE OF KANSAS }
COUNTY OF SEDGWICK } ss.:

On this 25 day of May, 1977, before me the undersigned, a Notary Public, in and for the County and State aforesaid, personally appeared C. W. Sebitts, to me known to be the identical person who subscribed the name of PICKRELL DRILLING COMPANY to the foregoing instrument as its Attorney-in-Fact and acknowledged to me that he executed the same as his free and voluntary act and deed, and as the free and voluntary act and deed of such company, for the uses and purposes therein set forth.

Given under my hand and seal of office the day and year last above written.



My commission expires: _____

[Signature]
Notary Public
Jo Ann Sarver