

15-155-20859-0000

STATE OF KANSAS
STATE CORPORATION COMMISSION
200 Colorado Derby Bldg.
Wichita, Kansas 67202


Form CP-4
Rev. 12-15-80

WELL PLUGGING RECORD

Give All Information Completely
Make Required Affidavit

COUNTY Reno SEC. 18 TWP. 22 RGE. 4 -E/W
Location as in quarters or footage from lines:

NW NE NW

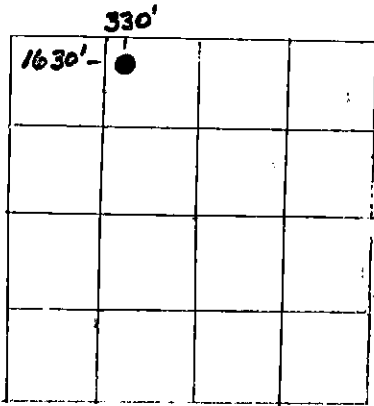

Locate Well
correctly on above
Section Platt.

Lease Owner R. J. Walker Oil Co., Inc.

Lease Name Bontrager Well No. 1-18

Office Address 3524 N. W. 56th St. Oklahoma City, Ok. 73112

Character of Well (Completed as Oil, Gas or Dry Hole): Dry Hole

Date Well Completed 1-24-82

Application for plugging filed 1-24-82

Plugging commenced 1-24-82

Plugging completed 1-24-82

Reason for abandonment of well or producing formation

Dry Hole

Was permission obtained from the Conservation Division or it's
Agent's before plugging was commenced? Yes

Name of Conservation Agent who supervised plugging of this well Merlin Unruh

Producing formation _____ Depth to top _____ bottom T.D. 3980'

Show depth and thickness of all water, oil and gas formations.

OIL, GAS OR WATER RECORDS

Casing Record

Formation	Content	From	To	Size	Put in	Pulled Out
				13-3/8"	140'	-0-

Describe in detail the manner in which the well was plugged, indicating where the mud fluid was placed and the method or methods used in introducing it into the hold. If cement or other plugs were used, state the character of same and depth placed, from _____ feet to _____ feet for each plug set.

Plugged @ 1200' 120 sax 18% salt & Cement @ 300' to surface
w/170 sax Class A Common ~~XXXXXXXXXX~~
5 sax in Rh & 5 sax in MH Hole plugged @ 6:15 AM

RECEIVED
STATE CORPORATION COMMISSION
3-4-82
MAR 4 1982

(If additional description is necessary, use BACK of this sheet)
Name of Plugging Contractor Kansas Drilling & Well Service, Inc. Wichita, Kansas

STATE OF Oklahoma COUNTY OF Oklahoma, ss.
O. N. Goode, Jr. (employee of owner) or (owner or operator) of the
above-described well, being first duly sworn on oath, says: That I have knowledge of the
facts, statements, and matters herein contained and the log of the above-described well as
filed and that the same are true and correct. So help me God.

(Signature) O. N. Goode, Jr.
V.P. - Engineering
(Address)

SUBSCRIBED AND SWORN TO before me this 2nd day of March, 19 82

Mary Kay Modreck
Notary Public.

My Commission expires: February 19, 1985