


Give All Information Completely
Make Return Affidavit
Mail or Deliver Report to:
Conservation Division
State Corporation Commission
800 Bitting Building
Wichita, Kansas

Reno County, Sec. 30 Twp. 22S Rge. 4 (E) 4 (W)

Location as "NE/CNW/SW" or footage from lines NW/4 NW/4 NW/4
Lease Owner J. A. Melland, et al
Lease Name Doerkson Well No. 1
Office Address 1111 North Main Street, Hutchinson, Kansas
Character of Well (completed as Oil, Gas or Dry Hole) Dry Hole
Date well completed January 3, 19 54
Application for plugging filed October 22, 19 54
Application for plugging approved October 22, 19 54
Plugging commenced October 22, 19 54
Plugging completed October 26, 19 54
Reason for abandonment of well or producing formation Dry Hole

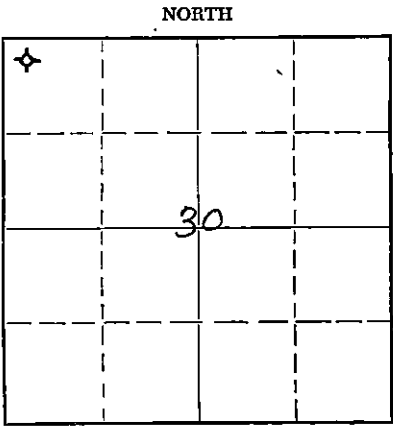

Locate well correctly on above Section Plat

If a producing well is abandoned, date of last production 19
Was permission obtained from the Conservation Division or its agents before plugging was commenced? Yes

Name of Conservation Agent who supervised plugging of this well Ruel Durkee
Producing formation None Depth to top Bottom Total Depth of Well 3861 Feet
Show depth and thickness of all water, oil and gas formations.

OIL, GAS OR WATER RECORDS

CASING RECORD

FORMATION	CONTENT	FROM	TO	SIZE	PUT IN	PULLED OUT
Mississippi Lime	Dry	3371	3380	8-5/8"	667'	None
Hunton	Dry	3732	3734	5-1/2"	3858'	3279'
Viola	Dry	3847	3854			
Simson	Dry	3858	3861			

Describe in detail the manner in which the well was plugged, indicating where the mud fluid was placed and the method or methods used in introducing it into the hole. If cement or other plugs were used, state the character of same and depth placed, from feet to feet for each plug set.

Chat from 3861' to 3845'
6 sacks of cement from 3845' to 3800'
Mud from 3800' to 250'
15 sacks of cement from 250' to 200'
Mud from 200' to 20'
5 sacks of cement from 20' to 6'
Surface soil from 6' to 0'

(If additional description is necessary, use BACK of this sheet)

Name of Plugging Contractor Morgan Well Plugging Service
Address 102 West Eighteenth, Hutchinson, Kansas

STATE OF Kansas, COUNTY OF Reno, ss.
J. A. Melland (employee of owner) or (owner or operator) of the above-described well, being first duly sworn on oath, says: That I have knowledge of the facts, statements, and matters herein contained and the log of the above-described well as filed and that the same are true and correct. So help me God.

(Signature) J. A. Melland
1111 North Main St., Hutchinson, Kansas
(Address)

SUBSCRIBED AND SWORN TO before me this 10 day of November, 1954
Ocean W. Oakes

My commission expires Oct. 31, 1955

Notary Public.

24-7868-6 3-53:20M

PLUGGING
FILE SEC 30 T 22 R 4W
BOOK PAGE 69 LINE 38

11-13-54

W E L L R E C O R D

LEASE NAME Doerkson WELL NO. 1 ELEVATION _____
 LOCATION NW/4 NW/4 NW/4 Section 30-228-14W, Reno County, Kansas
 WORK COMMENCED December 17, 1953 DRILLING COMMENCED December 20, 1953
 DRILLING COMPLETED January 3, 1954
 DRILLING CONTRACTOR J. A. Melland, Hutchinson, Kansas
 ROTARY DRILLING FROM 0' TO 3861'
 GEOLOGIST George Waits, Wichita, Kansas

FORMATION	FROM	TO	REMARKS
Top soil, sand	0	100	
Cley, shale & shells	100	190	
Shale & shells	190	400	
Shale, lime & shells	400	640	
Shale & shells	640	662	
Anhydrite	662	667	Set and cemented 8-5/8" OD casing at 667' w/450 sacks of cement.
Anhydrite	667	685	
Lime & shale	685	1170	
Lime	1170	1270	
Lime & shale	1270	1530	
Shale, lime & shells	1530	1790	
Shale & lime	1790	2625	
Lime & shale	2625	2975	
Shale & lime	2975	3190	
Lime & shale	3190	3345	
Chat & lime	3345	3384	Circulated 1 hour @ 3378'
Lime & chat	3384	3500	
Lime	3500	3542	
Lime & chert	3542	3564	
Chert & lime	3564	3586	
Lime	3586	3613	
Shale & lime	3613	3861	Top Simpson Sand 3857'
			Circulated 1 hour @ 3740'
ROTARY TOTAL DEPTH		3861	Circulated 1-3/4 hours @ 3859'
			Circulated 1-1/4 hours @ 3861'
			Set and cemented 5 1/2" OD casing at 3858' w/ 75 sacks of cement.
			Slope tests were taken at regular intervals and no deflections from vertical were recorded

C E R T I F I C A T E

COUNTY OF RENO)ss
 STATE OF KANSAS)

I, J. A. Melland, drilling contractor for the above well, after first being sworn upon my oath, hereby declare the facts and statements in this Well Record are true and correct to the best of my knowledge and belief.

Subscribed and sworn before me this _____ day of _____, 1954

PLUGGING
 FILE SEC 301 22A 44
 BOOK PAGE 69 LINE 38

10-13-54
 Notary Public

My commission expires _____