

15-155-20931-0000


STATE OF KANSAS
STATE CORPORATION COMMISSION
200 Colorado Derby Bldg.
Wichita, Kansas 67202

Form CP-4
Rev. 12-15-80

WELL PLUGGING RECORD

Give All Information Completely
Make Required Affidavit

COUNTY Reno SEC. 6 TWP. 22S RGE. 5W ~~XXW~~
Location as in quarters or footage from lines:
C SE NW

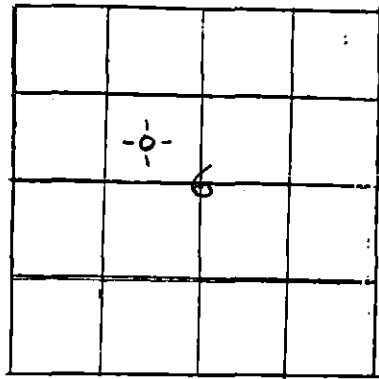

Locate Well
correctly on above
Section Platt.

Lease Owner Associated Petroleum Consultants, Inc.
Lease Name Blank Well No. #1
Office Address Suite 600 - One Main Place, Wichita, KS 67202-1399
Character of Well (Completed as Oil, Gas or Dry Hole): Dry Hole
Date Well Completed April 15, 1983
Application for plugging filed April 15, 1983
Plugging commenced 12:00 Midnight
Plugging completed 2:00 a.m.
Reason for abandonment of well or producing formation D & A

Was permission obtained from the Conservation Division or it's
Agent's before plugging was commenced? yes

Name of Conservation Agent who supervised plugging of this well Glen Ward, Wichita office
Producing formation X Depth to top X bottom X T.D. 4075'

Show depth and thickness of all water, oil and gas formations.

OIL, GAS OR WATER RECORDS Casing Record

Formation	Content	From	To	Size	Put in	Pulled Out
				8 5/8"	213'	none

Describe in detail the manner in which the well was plugged, indicating where the mud
fluid was placed and the method or methods used in introducing it into the hold. If cement
or other plugs were used, state the character of same and depth placed, from _____ feet
to _____ feet for each plug set.

- Ran 35 sacks @ 1000'
- 35 sacks @ 250'
- 20 sacks @ 50' & Bridge Plug
- 10 sacks Rat Hole
- 10 sacks Mouse Hole
- 5 sacks Water Well


(If additional description is necessary, use BACK of this sheet)
Name of Plugging Contractor Heartland Drilling, Inc.

STATE OF KANSAS COUNTY OF SEDGWICK, ss.
Phyllis Buchanan (employee of owner) ~~owner or operator~~ of the
above-described well, being first duly sworn on oath, says: That I have knowledge of the
facts, statements, and matters herein contained and the log of the above-described well as
filed and that the same are true and correct. So help me God.

(Signature) Phyllis Buchanan
PHYLLIS BUCHANAN
(Address)

SUBSCRIBED AND SWORN TO before me this 9th day of May, 19 83

My Commission expires: 6-29-85
SHERRY WAYMAN, Notary Public,
STATE CORPORATION COMMISSION

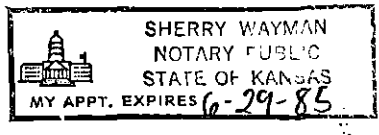

5-11-83
MAY 11 1983
CONSERVATION DIVISION
Wichita, Kansas