

STATE OF KANSAS  
STATE CORPORATION COMMISSION


Give All Information Completely  
Make Required Affidavit  
Mail or Deliver Report to:  
Conservation Division  
State Corporation Commission  
212 North Market, Insurance Bldg.  
Wichita, Kansas

15-155-00228-0000  
WELL PLUGGING RECORD

**Reno** County. Sec. 9 Twp. 22 Rge. 5 (W)

Location as "NE/CNW/SW" or footage from lines C SE NE  
Lease Owner Rupp-Ferguson Oil Co.  
Lease Name Wittorff Well No. 7  
Office Address 522 Union Center, Wichita, Kansas  
Character of Well (completed as Oil, Gas or Dry Hole) Dry Hole  
Date well completed 9-10-59 19  
Application for plugging filed 9-10-59 19  
Application for plugging approved 9-10-59 19  
Plugging commenced 9-10-59 19  
Plugging completed 9-10-59 19  
Reason for abandonment of well or producing formation \_\_\_\_\_

NORTH

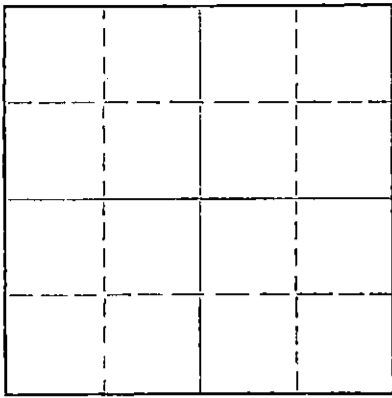

Locate well correctly on above  
Section Plat

If a producing well is abandoned, date of last production \_\_\_\_\_ 19  
Was permission obtained from the Conservation Division or its agents before plugging was commenced? Yes

Name of Conservation Agent who supervised plugging of this well Fred W. Hampel  
Producing formation \_\_\_\_\_ Depth to top \_\_\_\_\_ Bottom \_\_\_\_\_ Total Depth of Well 3935 Feet  
Show depth and thickness of all water, oil and gas formations.

OIL, GAS OR WATER RECORDS

CASING RECORD

FORMATION	CONTENT	FROM	TO	SIZE	PUT IN	PULLED OUT
				8 5/8"	248'	0

Describe in detail the manner in which the well was plugged, indicating where the mud fluid was placed and the method or methods used in introducing it into the hole. If cement or other plugs were used, state the character of same and depth placed, from \_\_\_\_\_ feet to \_\_\_\_\_ feet for each plug set.

Lay down D.P. Mud to 240' - Halls - Plug 18 sx cement; mud to 40' - Halls - Plug - Cement to base of cellar - Bridge D. Rathole - 2 sx cement.

**RECEIVED**  
STATE CORPORATION COMMISSION

SEP 17 1959

9-17-59  
CONSERVATION DIVISION  
Wichita, Kansas

(If additional description is necessary, use BACK of this sheet)  
Name of Plugging Contractor Rupp-Ferguson Oil Co.  
Address 522 Union Center, Wichita, Kansas

STATE OF Kansas, COUNTY OF Sedgwick, ss.  
(employee of owner) or (owner or operator) of the above-described well, being first duly sworn on oath, says: That I have knowledge of the facts, statements, and matters herein contained and the log of the above-described well as filed and that the same are true and correct. So help me God.

(Signature) [Signature]  
522 Union Center, Wichita, Kansas  
(Address)

SUBSCRIBED AND SWORN TO before me this 15th day of September, 1959

My commission expires May 11, 1963  
Marguerite Dickey Notary Public.

**PLUGGING**

File Sec. 9 T 22 R 5W  
Book Page 3 Line 39

