


STATE OF KANSAS
STATE CORPORATION COMMISSION

Give All Information Completely
Make Required Affidavit
Mail or Deliver Report to:
Conservation Division
State Corporation Commission
211 No. Broadway
Wichita, Kansas

15-155-02035-0000
WELL PLUGGING RECORD

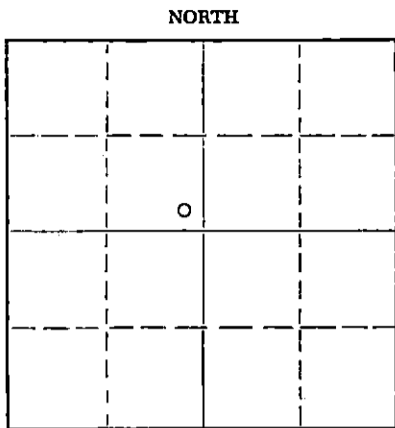

Locate well correctly on above Section Plat

Reno County, Sec. 36 Twp. 22 S Rge. (E) 4 (W)
Location as "NE/CNW/SW" or footage from lines Ctr. SE/4 NW/4
Lease Owner Messman-Rinehart Oil Company
Lease Name Martens "A" Well No. 1
Office Address 518 Petroleum Building, Wichita, Kansas
Character of Well (completed as Oil, Gas or Dry Hole) Dry Hole
Date well completed January 2 19 58
Application for plugging filed January 2 19 58
Application for plugging approved January 3 19 58
Plugging commenced January 5 19 58
Plugging completed January 8 19 58
Reason for abandonment of well or producing formation non-commercial production

If a producing well is abandoned, date of last production 19
Was permission obtained from the Conservation Division or its agents before plugging was commenced? yes

Name of Conservation Agent who supervised plugging of this well J. Lewis Brock, Krause Bldg., Great Bend, Ks.
Producing formation Depth to top Bottom Total Depth of Well 3370 Feet
Show depth and thickness of all water, oil and gas formations.

OIL, GAS OR WATER RECORDS

CASING RECORD

FORMATION	CONTENT	FROM	TO	SIZE	PUT IN	PULLED OUT
				10 3/4"	243'	none
				5 1/2"	3370'	3125'

Describe in detail the manner in which the well was plugged, indicating where the mud fluid was placed and the method or methods used in introducing it into the hole. If cement or other plugs were used, state the character of same and depth placed, from feet to feet for each plug set.

Plugged back w/crushed rock to 3310', dumped 5 sax cement @ 3310' w/dump bailer. Top of cement, 3275'. Filled hole w/mud to 225', set rock bridge, dumped 20 sax cement. Top of cement, 170'. Filled hole w/mud to 35', set rock bridge, dumped 10 sax cement for cap.

RECEIVED
STATE CORPORATION COMMISSION
MAR 7 1958
CONSERVATION DIVISION
Wichita, Kansas

(If additional description is necessary, use BACK of this sheet)
Name of Plugging Contractor Miller Casing Pulling Company License #12
Address P. O. Box 711, Great Bend, Kansas

STATE OF Kansas, COUNTY OF Sedgwick, ss.
J. A. Gilliland (employee of owner) of the above-described well, being first duly sworn on oath, says: That I have knowledge of the facts, statements, and matters herein contained and the log of the above-described well as filed and that the same are true and correct. So help me God.

(Signature) J. A. Gilliland
518 Petroleum Building, Wichita, Kansas (Address)

SUBSCRIBED AND SWORN TO before me this 20th day of January, 19 58

My commission expires December 1, 1960

Barbara J. Scott, Notary Public.

PLUGGING
FILE SEC 36 T 22 R 4E
73 LINE 23

NO. 1 MARTENS "A"

Well Record

Location:	Ctr. SE NW, Sec. 36-22S-4W Reno County, Kansas	Commenced:	December 16, 1957
Operator:	Messman-Rinehart Oil Company 518 Petroleum Building Wichita, Kansas	Completed:	January 2, 1958
Contractor:	Messman-Rinehart Oil Company 518 Petroleum Building Wichita, Kansas	Elevation:	1448 K/B
Casing Record:	10-3/4" @ 243' w/167 sx. cen. 5-1/2" @ 3370' w/50 sx. cen.	Production:	D C A

*** LOG ***

Clay	60
Clay	85
Sand & Gravel	130
Clay	200
Sand	210
Clay	215
Shale	243
Shale	515
Anhydrite	545
Shale & Shells	570
Shale & Lime	860
Lime	996
Lime	1070
Shale & Lime	1110
Lime & Shale	1360
Lime & Shale	1530
Lime & Shale	1635
Lime & Shale	1805
Lime & Shale	2060
Lime & Shale	2200
Lime & Shale	2255
Shale - Lime	2458
Lime & Shale	2558
Lime	2658
Lime - Shale	2798
Lime & Shale	2840
Lime & Chert	2985
Lime	2941
Lime & Shale	3040
Lime & Shale	3120
Shale & Lime	3292
Lime & Shale	3335
Lime & Shale	3345
Lime & Shale	3370 R.T.D.

3-7-58

Sample Tops:

2519' (-1072) Lansing
3261' (-1814) Mississippi

The undersigned, MESSMAN-RINEHART OIL COMPANY, hereby certifies that the above log is a true and correct log of the formation encountered in drilling the above well as reflected by the Daily Drilling Report.

MESSMAN-RINEHART OIL COMPANY

By: J. A. Gilliland
J. A. Gilliland

Subscribed and sworn to before me
20th day of January, 1958.

J. A. Gilliland
Notary Public

PLUGGING
FILE SEC 36 T. 22 R. 44
BOOK PAGE 73 LINE 23

COMPLETION DATA

Hessman-Rinchart Oil Company
No. 1 Hartena "A"
Ctr. SE/4 NW/4, Sec. 36-22S-4W
Reno County, Kansas

January 20, 1958

12/28/57	-	H.I.C.T.		
12/29/57	-	Perf. 3328-36' w/32 ^s - 1000 gal. acid, Baled 2 BOPH & 4 BWPH		
12/30/57	-	Moving swab tanks		
		Swab Tests:	<u>Oil</u>	<u>Water</u>
		2 hrs.	5 bbls.	20 bbls.
		1 hr.	1 "	9 "
		1 hr.	4 "	4 "
		1 hr.	3 "	7 "
12/31/57	-	2 hrs.	2 $\frac{1}{2}$ "	10 "
		2 hrs.	1.74 "	8 "
1/2/58	-	Last 24 hrs. made 10 bbls. oil and 47 bbls. water Dry and Abandoned - 1/2/58		

RECEIVED
STATE OF KANSAS
3-7-58
MAR 7 1958

CONSERVATION DIVISION
Wichita, Kansas

PLUGGING
SEC 36 T. 22 R. 4W
BOOK PAGE 73 LINE 23