

7-13-36 WELL PLUGGING RECORD


OR  
FORMATION PLUGGING RECORD

Strike out upper line when reporting plugging of formations.

Give All Information Completely  
Make Required Affidavit  
Mail or Deliver Report to:  
Conservation Division  
State Corporation Commission,  
800 Bitting Building,  
Wichita, Kansas

RECEIVED  
BY JUL 18 1936

Location as "NE 1/4 NW 1/4 SW 1/4" or footage from lines 330 N. 4.5 LINE - 355 W. of E. LINE  
 County Reno Sec. 5E SW 36 Twp. 22S Rge. 4W (E) SW (W)  
 Lease Owner Manning & Martin Inc  
 Lease Name Abraham Dick Well No. 1  
 Office Address 410 Phillower Bed, Tulsa Okla.  
 Character of Well (Completed as Oil, Gas or Dry Hole) Oil well  
 Date, well completed 12-30-1933  
 Application for plugging filed 7-2 1936  
 Application for plugging approved 7-2 1936  
 Plugging Commenced 7-7 1936  
 Plugging Completed 7-9 1936  
 Reason for abandonment of well or producing formation Stop Producing  
 If a producing well is abandoned, date of last production May 28th 1936  
 Was permission obtained from the Conservation Division or its agents before plugging was commenced? yes

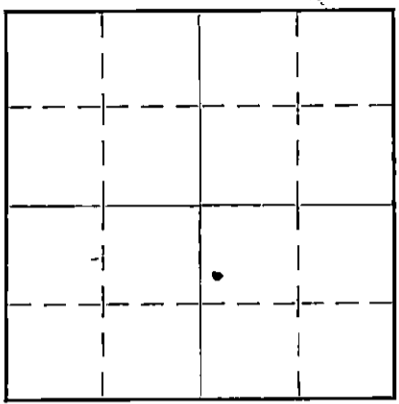

Locate well correctly on above Section Flat

Name of Conservation Agent who supervised plugging of this well W. D. Russell  
 Producing formation Coal Depth to top 3290 Bottom 3321 Total Depth of Well 3321 Feet  
 Show depth and thickness of all water, oil and gas formations.

OIL, GAS OR WATER RECORDS

CASING RECORD

Formation	Content	From	To	Size	Put In	Pulled Out
<u>Coal</u>	<u>91</u>	<u>3230</u>	<u>3321</u>	<u>12 1/2</u>	<u>295</u>	
				<u>10</u>	<u>575</u>	
				<u>6 5/8</u>	<u>3290</u>	<u>2000</u>

Describe in detail the manner in which the well was plugged, indicating where the mud fluid was placed and the method or methods used in introducing it into the hole. If cement or other plugs were used, state the character of same and depth placed, from \_\_\_\_\_ feet to \_\_\_\_\_ feet for each plug set.

Filled with mud from 3290 - to 3321, cement from 3275 to 3290. Dumped cement with Bailor. Bridged hole at 625, filled with mud to 575. Put cement to 550, lapped, plug set 15ft down in 10" pipe cement solid to surface.

295' 12 1/2" cemented solid to collar when run.  
575' 10" " " " " " "

PLUGGING  
 FILE SEC 36 Twp 22 R 4W  
 BOOK PAGE 52 LINE 13

(If additional description is necessary use BACK of this sheet)  
 Correspondence regarding this well should be addressed to Manning & Martin Inc  
 Address 410 Phillower Bed Tulsa Okla

STATE OF Kansas COUNTY OF Reno, ss.  
Howard Smith foreman (employee of owner) or (owner or operator) of the above-described well, being first duly sworn on oath, says: That I have knowledge of the facts, statements, and matters herein contained and the log of the above-described well as filed and that the same are true and correct. So help me God.

(Signature) Howard Smith

(Address)

SUBSCRIBED AND SWORN to before me this 10 day of July 1936

My commission expires June 13 - 1940

Notary Public.

15-153-19148-0000

MANNING & TERRY, INC.

P. O. Box 347

TULSA, OKLAHOMA

LOG WELL #1. ABRAHAM DICK FARM - 330' N. OF S. LINE-355' W. OF E. LINE SE-SW-36-22S-4W-RENO COUNTY, KANSAS.

COMPANY: MANNING & TERRY, INC. ET AL  
CONTRACTOR: MANNING & TERRY, INC.

ELEVATION - 1451'  
COMM. DRLG. 11-9-33  
COMP. DRLG. ROTARY 12-18-33  
COMP. DRLG. CABLE 12-30-33  
TOTAL DEPTH - 3321'  
INITIAL PROD. 1765 BBLs.  
DAILY

CASING RECORD:-

12 1/2" 45# 296'  
10" 575'  
6 5/8" 24# 3230'

<u>FORMATION</u>	<u>THICKNESS</u>	<u>TOTAL DEPTH</u>
SURFACE SAND AND CLAY	295	295
LIME	1	296
LIME	2	298
SHALE AND SHELLS	182	480
BROKEN LIME AND GYP.	10	490
LIME AND SHALE	15	505
SHALE AND LIME SHELLS	114	695
SHALE	70	575
LIME AND SHALE	6	581
LIME AND SHALE	1285	1980
LIME	218	2198
SHALE AND LIME	117	2315
SAND	33	2348
SHALE AND LIME	48	2396
LIME	19	2415
SHALE	95	2510
LIME (K. C. LIME)	106	2616
LIME AND SHALE	41	2657
BROKEN LIME	53	2710
SHALE	16	2726
LIME AND SHALE	101	2827
BROKEN LIME	21	2848
LIME AND SHALE	10	2858
BROKEN LIME	53	2911
LIME AND SHALE	151	3062
SHALE	48	3110
BROKEN LIME AND SHALE	111	3221
CHAT	9	3230
CHAT	91	3321
TOTAL DEPTH	3321	3321'

36 22 4W  
52 13