

15-055 20484-0000

FORM CP-4

STATE OF KANSAS  
STATE CORPORATION COMMISSION

WELL PLUGGING RECORD

Give All Information Completely  
Make Required Affidavit  
Mail or Deliver Report to  
Conservation Division  
State Corporation Comm.  
245 North Water  
Wichita, KS 67202


Finney County. Sec. 19 Twp. 26 Rge. 34 N/W  
Location as "NE/CNW $\frac{1}{4}$ SW $\frac{1}{4}$ " or footage from lines  
1650' FNL, 2310' FEL

Lease Owner Winfield Resources  
Lease Name Cisco Dome Oil & Gas "MD" Well No. 1  
Office Address P.O. Box 880 Parker, Colorado 80134  
Character of Well (Completed as Oil, Gas or Dry Hole)  
Dry Hole

Date Well completed 8-26 1981  
Application for plugging filed 8-26 1981  
Application for plugging approved 8-26 1981  
Plugging commenced 9:30 P.M. 8-26 1981  
Plugging completed 1:15 A.M. 8-27 1981  
Reason for abandonment of well or producing formation  
Dry Hole

If a producing well is abandoned, date of last production  
19

Was permission obtained from the Conservation Division or  
its agents before plugging was commenced? Yes

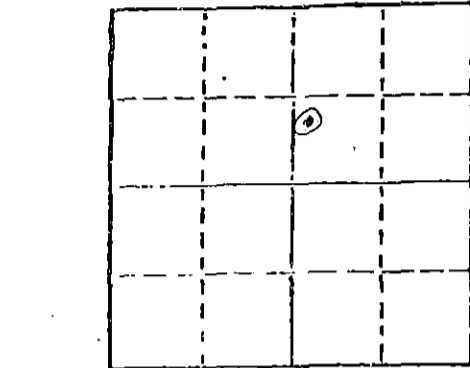

Locate well correctly on above  
Section Plot

Name of Conservation Agent who supervised plugging of this well Thomas  
Producing formation \_\_\_\_\_ Depth to top \_\_\_\_\_ Bottom \_\_\_\_\_ Total Depth of Well 4540'  
Show depth and thickness of all water, oil and gas formations.

OIL, GAS OR WATER RECORDS

CASING RECORD

FORMATION	CONTENT	FROM	TO	SIZE	PUT IN	PULLED OUT
		0	817	8 5/8	817	Left

Describe in detail the manner in which the well was plugged, indicating where the mud fluid  
was placed and the method or methods used in introducing it into the hold. If cement or other  
plugs were used, state the character of same and depth placed, from \_\_\_\_\_ feet to  
\_\_\_\_\_ feet for each plug set.

140 Sx. @ 3100'

Rubber Plug to 800' 40 Sx. @ 800'

10 Sx. 40' to 0  
5 Sx. Rathole

Completed @ 1:15 A.C. 8-27-81 by Howco

RECEIVED  
STATE CORPORATION COMMISSION

SEP - 1 1981

CONSERVATION DIVISION  
Wichita, Kansas

(If additional description is necessary, use BACK of this sheet)

Name of Plugging Contractor Howco


STATE OF KANSAS COUNTY OF SEWARD, ss.  
R. L. Higginbottom, agent (employee of owner) or (owner or operator)  
of the above-described well, being first duly sworn on oath, says: That I have knowledge of  
the facts, statements, and matters herein contained and the log of the above-described well  
as filed and that the same are true and correct. So help me God.

(Signature) R. L. Higginbottom  
Box 6; Liberal, Ks 67901  
(Address)

SUBSCRIBED AND SWORN TO before me this 31st day of August, 19 81

A. J. Parnell  
Notary Public.

My commission expires \_\_\_\_\_

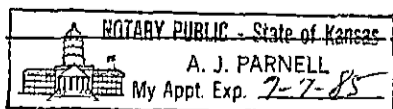

OPERATOR: Winfield Resources  
 CONTRACTOR: Lakin Drilling Co.  
 WELL NAME: Cisco Dome Oil & Gas "MD" #1  
 LOCATION: 19-26-34  
Finney County, Kansas  
 GEOLOGIST: \_\_\_\_\_  
 SPUD DATE: 8-14-81  
 COMPLETION DATE: 8-27-81

FOOTAGE:		
<u>0</u>	<u>460</u>	<u>Clay &amp; Sand</u>
<u>460</u>	<u>765</u>	<u>Shale</u>
<u>765</u>	<u>817</u>	<u>Shale &amp; Gyp</u>
<u>817</u>	<u>1396</u>	<u>Shale</u>
<u>1396</u>	<u>1570</u>	<u>Sand &amp; Salt</u>
<u>1570</u>	<u>1881</u>	<u>Shale &amp; Salt</u>
<u>1881</u>	<u>1892</u>	<u>Anhy.</u>
<u>1892</u>	<u>2450</u>	<u>Shale</u>
<u>2450</u>	<u>3440</u>	<u>Shale &amp; Lime</u>
<u>3440</u>	<u>4390</u>	<u>Lime</u>
<u>4390</u>	<u>4540</u>	<u>Lime &amp; Chert</u>
_____	_____	_____
_____	_____	_____
_____	_____	_____
_____	_____	_____

REPORT: Spud in @ 7:30 P.M. 8-14-81 12 1/4" Hole to 817'  
Run 20 Jts. 8 5/8" 24# Csg. 807.79' Set @ 817' Cement with 350 Lite  
1/4# Flocele 2% c.c. & 150 "H" 3/8 c.c. Plug down 7:40 P.M.  
8-15-81 by Howco

Plug hole = 140 Sx. @ 3100'  
Rubber Plug to 800' 40 Sx. @ 800'  
10 Sx. @ 40' to 0  
5 sx. Rathole  
Completed @ 1:15 A.M. 8-27-81 by Howco

RECEIVED  
 STATE CORPORATION COMMISSION  
 SEP - 1 1981  
 CONSERVATION DIVISION  
 Wichita, Kansas

\*\*\*\*\*

State of Kansas County of Kearny  
 Louis C Blankenship, Drilling Supt for Lakin Drilling Co, does hereby state that the above and foregoing is a true and correct copy of the log of the Cisco Dome "MD" #1 lease; 19-26-34 (legal); Finney (county); Kansas.

LAKIN DRILLING COMPANY  
 By: Louis C Blankenship  
 Louis C Blankenship, Drilling Supt.

Subscribed and sworn to before me, a Notary Public, in and for the aforesaid county and state as of this 28th day of August, 1981.

Nina M. Wellmaker  
 Notary Public

My Commission Expires: 6-15-81

