

15-055-66049-00-01


STATE OF KANSAS
STATE CORPORATION COMMISSION

Form CP-4

Give All Information Completely
Make Required Affidavit
Mail or Deliver Report to
Conservation Division
State Corporation Commission
P. O. Box 17027
Wichita, Kansas 67217
NORTH

WELL PLUGGING RECORD

Finney County, Sec. 7 Twp. 26S Rgo. 34 (W)
Location as "NE/CNWSW" or footage from lines C SW SW
Lease Owner Champlin Petroleum Company
Lease Name Campbell Well No. 2
Office Address 6441 N.W. Grand Blvd. #300, OKC, OK 73116
Character of Well (completed as Oil, Gas or Dry Hole) Oil
Date well completed March 19 59
Application for plugging filed September 22 19 82
Application for plugging approved October 3 19 82
Plugging commenced October 18 19 82
Plugging completed October 18 19 82
Reason for abandonment of well or producing formation Depleted formation,
no recompletion possibilities
If a producing well is abandoned, date of last production November 10 78
Was permission obtained from the Conservation Division or its agents before plugging was commenced? yes

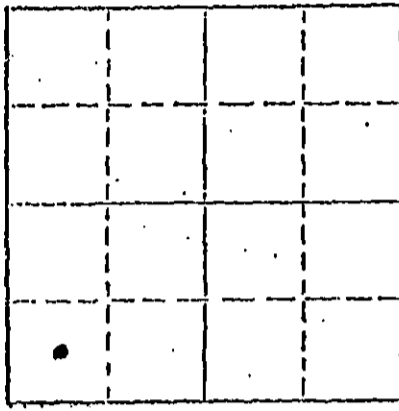

Locate well correctly on above Section Plat

Name of Conservation Agent who supervised plugging of this well Paul Luthi
Producing formation Mississippi Depth to top 5121 Bottom 5136 Total Depth of Well 5182 Feet
Show depth and thickness of all water, oil and gas formations. Morrow 4916-4940

OIL, GAS OR WATER RECORDS

CASING RECORD

FORMATION	CONTENT	FROM	TO	SIZE	PUT IN	PULLED OUT
				10 - 3/4"	830'	0
				7"	5181'	0

Describe in detail the manner in which the well was plugged, indicating where the mud fluid was placed and the method or methods used in introducing it into the hole. If cement or other plugs were used, state the character of same and depth placed, from _____ feet to _____ feet for each plug set.

Ran bailer and cleaned out paraffin at 1500'. Ran and set CTBP at 4800'. Formation fluid at 1500'. Set second CTBP at 1500'. Cement 7" casing to surface w/210 sacks Lite-Wate cement. Well plugged at 5:30 pm 10/18/82.

RECEIVED
STATE CORPORATION COMMISSION

NOV 12 1982 11-12-82

CONSERVATION DIVISION
Wichita, Kansas

(If additional description is necessary, use BACK of this sheet)
Name of Plugging Contractor Halliburton
Address _____

STATE OF Oklahoma, COUNTY OF Oklahoma ss.

J. W. Meyers (employee of owner) or (owner or operator) of the above-described well, being first duly sworn on oath, says: That I have knowledge of the facts, statements, and matters herein contained and the log of the above-described well as filed and that the same are true and correct. So help me God.

(Signature) *J. W. Meyers*

6441 N.W. Grand Blvd., #300, OKC, OK 73116
(Address)

Subscribed and sworn to before me this 9th day of November 1982

Notary Public
Notary Public

My commission expires 10/08/83

CHAMPLIN OIL & REFINING CO.
EARL W. CAMPBELL #2.
C SW SW 7-26S-34W
FINNEY COUNTY
KANSAS

15-055-00049-0001

0	-	725	Sand, Shale & Gyp
725	-	815	Sand & Shale
815	-	1635	Sand, Shale & Red Bed
1635	-	2330	Sand & Shale
2330	-	3019	Lime & Shale
3019	-	3580	Lime
3580	-	3700	Lime & Shale
3700	-	3890	Lime, Shale & Chalk
3890	-	3988	Lime & Chalk
3988	-	4385	Lime
4385	-	4440	Lime & Chalk
4440	-	4945	Lime
4945	-	4954	Lime & Sand
4954	-	5104	Lime
5104	-	5182	Miss. Lime
5182	-		T.D.

STATE OF Kansas, COUNTY OF Barton,

H. E. Morgan (Employee of Owner) of the above described well, being first duly sworn on oath, says:

That I Have Knowledge of the facts, statements, and matters herein contained and the log of the above-described well as filed and that the same are true and correct. So help me God.

(Signature) H. E. Morgan

Box 167, Ellinwood, Kansas
(Address)

Subscribed and Sworn to before me this 28th day of May 1959

[Signature]
Notary Public

My commission expires 5-22-62

RECEIVED
STATE CORPORATION COMMISSION

SEP 22 1982 9-22-82

CONSERVATION DIVISION
Wichita, Kansas