

15-055-10018-0000


STATE OF KANSAS
STATE CORPORATION COMMISSION

Form CP-4

WELL PLUGGING RECORD

Give All Information Completely
Make Required Affidavit
Mail or Deliver Report to:
Conservation Division
State Corporation Commission
P. O. Box 17027

Wichita, Kansas 67217
NORTH

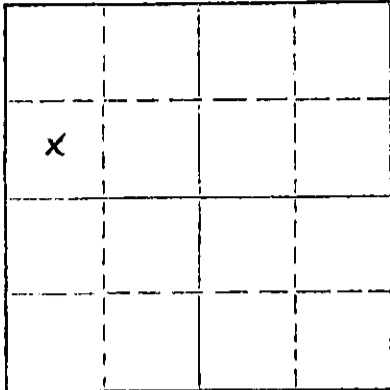

Locate well correctly on above
Section Plat

Finney County, Sec. 7 Twp. 26 Rge. (E) 34 (W)
Location as "NE/CNW/SW" or footage from lines C SW NW
Lease Owner Champlin Petroleum Company
Lease Name C. Lee Reeve Well No. 3
Office Address 6051 N. Brookline, Suite 116, Okla. City, Okla. 73112
Character of Well (completed as Oil, Gas or Dry Hole) Oil
Date well completed 11-29 19 61
Application for plugging filed 5-29-74 (Renewal 9-10 19 75)
Application for plugging approved 5-31-74 (Renewed 9-15 19 75)
Plugging commenced 9-12 19 75
Plugging completed 9-16 19 75
Reason for abandonment of well or producing formation depleted & uneconomical

If a producing well is abandoned, date of last production May 19 69
Was permission obtained from the Conservation Division or its agents before plugging was commenced? Yes

Name of Conservation Agent who supervised plugging of this well Clarence Thomas, 403 Davis, Garden City, Kansas
Producing formation Morrow-Mississippi Depth to top 4914' Bottom 5072' Total Depth of Well 5190 Feet
Show depth and thickness of all water, oil and gas formations.

OIL, GAS OR WATER RECORDS

CASING RECORD

FORMATION	CONTENT	FROM	TO	SIZE	PUT IN	PULLED OUT
Morrow	Oil	4914'	4983'	8-5/8"	815'	None
Mississippi	Oil	5000'	5072'	5-1/2"	5190'	1244'

Describe in detail the manner in which the well was plugged, indicating where the mud fluid was placed and the method or methods used in introducing it into the hole. If cement or other plugs were used, state the character of same and depth placed, from _____ feet to _____ feet for each plug set.

Pumped in 2 sacks hulls, followed with 25 sacks common cement. Top of plug at 4100'.
Shot 5 1/2" casing at 3687', 3014', 2405', 1806', 1244'. Pipe came loose at 1244' and
pulled 16 jts. Pumped 50 sacks cement displaced with mud. Cement plug from 765'-865'.
Finished pulling 5 1/2" casing. Capped 8-5/8" surface casing with 10 sacks cement 3'-33'.
Cut casing off 3' below ground level & welded on cap.

RECEIVED
STATE CORPORATION COMMISSION

SEP 29 1975

CONSERVATION DIVISION
Wichita, Kansas

(If additional description is necessary, use BACK of this sheet)

Name of Plugging Contractor Lillard Casing Pulling, Inc.
Address P. O. Box 962, Woodward, Oklahoma

STATE OF Oklahoma, COUNTY OF Oklahoma, ss.
Harold E. Melvin

(employee of owner) or (owner/proprietor) of the above-described well, being first duly sworn on oath, says: That I have knowledge of the facts, statements, and matters herein contained and the log of the above-described well as filed and that the same are true and correct. So help me God.

(Signature) Harold E. Melvin
6051 N. Brookline, Suite 116, Okla. City, Okla.
(Address) 73112

SUBSCRIBED AND SWORN TO before me this 25th day of September, 1975

My commission expires 10-8-75

Notary Public.

CERTIFIED DRILLER'S LOG

RECEIVED
STATE CORPORATION COMMISSION
MAY 31 1974
CONSERVATION DIVISION
Wichita, Kansas

COMPANY: CHAMPLIN OIL & REFINING COMPANY
CONTRACTOR: LONITA OIL CORPORATION, INC.
COMMENCED: NOVEMBER 5, 1961
COMPLETED: NOVEMBER 29, 1961
LEASE: C. LEE REEVE - WELL NUMBER 3
LOCATION: 7 - 26S - 34W
FINNEY COUNTY, KANSAS
CASING RECORD: 815' 8 5/8", Cem. w/400 Sacks
5187' 5 1/2", Cem. w/300 Sacks

<u>FORMATION:</u>	<u>DEPTH:</u>
Sand	0 - 320
Shale & Shells	320 - 745
Red Bed	745 - 816
Red Bed & Shale	816 - 1395
Sand	1395 - 1620
Sand & Shale	1620 - 1950
Shale & Shells	1950 - 2300
Anhydrite	2300 - 2360
Shale - Lime & Shells	2360 - 2444
Shale & Lime	2444 - 3772
Chalky Lime	3772 - 3905
Chalky Lime & Shale	3905 - 3988
Shale & Chalky Lime	3988 - 4028
Lime & Shale Chalk	4028 - 4155
Shale & Lime	4155 - 5057
Lime	5057 - 5139
Shale & Lime	5139 - 5155
Lime	5155 - 5190
RTD	5190

I hereby certify that this is a true and correct copy of the above log to the best of my knowledge.


R. E. Hartman

STATE OF KANSAS)
COUNTY OF SEDGWICK) SS

Subscribed and sworn to before me this 23rd day of January, 1962.


Notary Public

My commission Expires:

November 28, 1964