


Get All Information Completely  
Make Required Affidavit  
Mail or Deliver Report to:  
Conservation Division  
State Corporation Commission  
211 No. Broadway  
Wichita, Kansas

**WELL PLUGGING RECORD**

NORTH

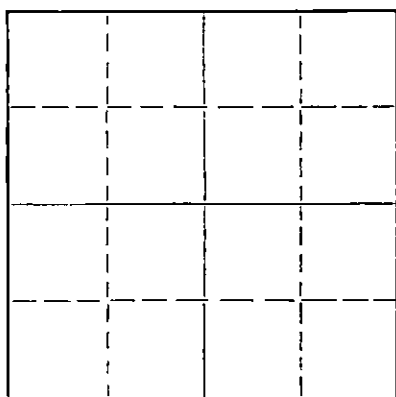

Locate well correctly on above  
Section Plat

Finney County. Sec. 6 Twp. 26S Rge. 34 (NE) W (W)  
Location as "NE/CNW/SW" or footage from lines 660' FR. S & 1980' FR. E  
Lease Owner Helmerich & Payne, Inc.  
Lease Name U.S.A. "E" Well No. 2  
Office Address Box 255; Garden City, Kansas  
Character of Well (completed as Oil, Gas or Dry Hole) Dry Hole  
Date well completed \_\_\_\_\_ 19\_\_\_\_  
Application for plugging filed Yes 19\_\_\_\_  
Application for plugging approved Yes 19\_\_\_\_  
Plugging commenced 2/19/60 19\_\_\_\_  
Plugging completed 2/28/60 19\_\_\_\_  
Reason for abandonment of well or producing formation Dry Hole

If a producing well is abandoned, date of last production \_\_\_\_\_ 19\_\_\_\_  
Was permission obtained from the Conservation Division or its agents before plugging was commenced? Yes

Name of Conservation Agent who supervised plugging of this well Mr. Frank Broadfoot  
Producing formation \_\_\_\_\_ Depth to top \_\_\_\_\_ Bottom \_\_\_\_\_ Total Depth of Well 5,000 Feet  
Show depth and thickness of all water, oil and gas formations.

OIL, GAS OR WATER RECORDS

CASING RECORD

FORMATION	CONTENT	FROM	TO	SIZE	PUT IN	PULLED OUT
		Surface	852	8 5/8	852	None
		Surface	5231	4 1/2	5231	1,752
		<u>3-3-60</u>				

Describe in detail the manner in which the well was plugged, indicating where the mud fluid was placed and the method or methods used in introducing it into the hole. If cement or other plugs were used, state the character of same and depth placed, from \_\_\_\_\_ feet to \_\_\_\_\_ feet for each plug set.

Plugging commenced 2/19/60. Plugging completed 2/28/60. Measured in on plug at 4500'. Plugged off bottom at 4500' with 15' of sand and dumped 5 sacks of cement, 4500'-4470'. Filled hole with 55 viscosity mud back to 1500'. Worked pipe. Loaded hole with water. Shot 4 1/2" casing at 1752'. Pulled and laid down casing, after spotting 20 sacks of cement at 1750', 1750'-1690'. Bailed down hole and pushed plug of 1/2 sacks of hulls and 10' sand to 750'. Mixed 20 sacks of cement, 750'-690'. Mudded hole up to 40', with 55 viscosity mud. Set 10' rock bridge, 40'-30'. Capped the well with 10 sacks of cement, 30'-0'. Cemented 4 1/2" pipe above the ground 4' per government regulations. Tore down well.

(If additional description is necessary, use BACK of this sheet)

Name of Plugging Contractor J. O. Forbes d/b/a Forbes Casing Pulling Company  
Address Box 221, Great Bend; Kansas

STATE OF KANSAS, COUNTY OF FINNEY, ss.  
T. E. MORT (employee of owner) or (~~OWNER~~) of the above-described well, being first duly sworn on oath, says: That I have knowledge of the facts, statements, and matters herein contained and the log of the above-described well as filed and that the same are true and correct. So help me God.

(Signature) T. E. Mort  
BOX 255; Garden City, Kansas  
(Address)

SUBSCRIBED AND SWORN to before me this 2 day of March, 1960

Russell Wells  
Notary Public.

My commission expires 11/29/60



WELL LOG BUREAU—KANSAS GEOLOGICAL SOCIETY  
503 East Murdock, Wichita, Kansas


15-055-16000-0000  
COPY

Company-HELMERICH & PAYNE, INC.  
Farm-USA "E" No. 2

SEC. 6 T. 26 R. 34W  
C SW SE

Total Depth. 5246'  
Comm. 12-9-59 Comp. 12-24-59  
Shot or Treated.  
Contractor.  
Issued. 3-19-60

County Finney  
KANSAS

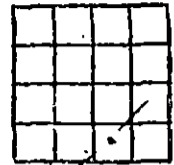

CASING:  
8 5/8" 853' cem. w/350 sx.  
4 1/2" 5240'

Elevation. 3008DF

Production. Dry

Figures Indicate Bottom of Formations.

sand & clay	815
red bed & clay	1111
red bed & sand	1805
sand & shale	2076
shale & anhydrite	2350
shale & lime	2495
lime & shale	3075
lime	3121
lime & shale	3350
shale & lime	3505
lime & shale	3756
shale & lime	3900
lime & shale	4110
shale & lime	4285
lime, shale & chalk	4384
lime & shale	4633
shale & lime	4704
lime & shale	4773
lime & sand	4835
lime & shale	5095
lime	5246
Total Depth	

TOIS: ELECTRIC LOG

Topeka	3460
Heebner	3865
Toronto	3882
Paris	3916
Base Kansas City	4469
Marmaton	4495
Cherokee	4642
Atoka	4843
Morrow	4907
St. Genevieve	5019
St. Louis	5095
"B" Zone	5097-5109
"C" Zone	5168-5175
"D" Zone	5198-5203