


STATE OF KANSAS  
STATE CORPORATION COMMISSION

Form CP-4

Give All Information Completely  
Make Required Affidavit  
Mail or Deliver Report to:  
Conservation Division  
State Corporation Commission  
P. O. Box 17027  
Wichita, Kansas 67217

WELL PLUGGING RECORD

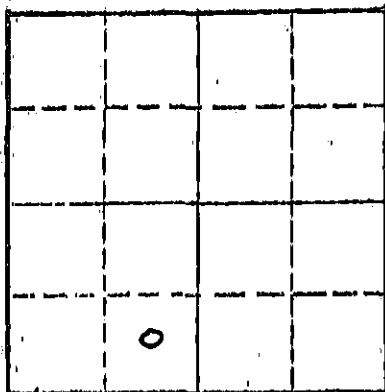

Locate well correctly on above  
Section Plat

Hodgeman County, Sec. 9 Twp. 24 Rge. 23W (E) (W)  
Location as "NE/CNW/SE/SW" or footage from base C SE SW  
Lease Owner Donald C. Slawson  
Lease Name Wade "B" Well No. 1  
Office Address 408 120 Building, Wichita, Kansas 67202  
Character of Well (completed as Oil, Gas or Dry Hole) Dry Hole  
Date well completed November 6 1974  
Application for plugging filed November 6 1974  
Application for plugging approved November 6 1974  
Plugging commenced November 5 1974  
Plugging completed November 6 1974  
Reason for abandonment of well or producing formation Dry Hole

If a producing well is abandoned, date of last production 10  
Was permission obtained from the Conservation Division or its agents before plugging was commenced? Yes

Name of Conservation Agent who supervised plugging of this well Clarence F. Thomas, 403 Davis, Garden City, Kansas  
Producing formation Depth to top Bottom Total Depth of Well 4800 Feet 67846  
Show depth and thickness of all water, oil and gas formations.

OIL, GAS OR WATER RECORDS

CASING RECORD

FORMATION	CONTENT	FROM	TO	SIZE	PUT IN	PULLED OUT
8 5/8"	280'				287'	

Describe in detail the manner in which the well was plugged, indicating where the mud fluid was placed and the method or methods used in introducing it into the hole. If cement or other plugs were used, state the character of same and depth placed, from feet to feet for each plug set.

1st plug @ 850' w/50 sx  
2nd plug @ 550' w/35 sx  
3rd plug @ 45' w/15 sx

RECEIVED  
STATE CORPORATION COMMISSION  
NOV 15 1974  
CONSERVATION DIVISION  
Wichita, Kansas

(If additional description is necessary, use BACK of this sheet)  
Name of Plugging Contractor Slawson Drilling Company, Inc.  
Address 408 120 Building, Wichita, Kansas 67202

STATE OF KANSAS COUNTY OF SEDGWICK  
James C. Remsberg (employee of owner) or (owner or operator) of the above-described well, being first duly sworn on oath, says: That I have knowledge of the facts, statements, and matters herein contained and the log of the above-described well as filed and that the same are true and correct. So help me God.

(Signature) James C. Remsberg

Subscribed and sworn to before me this 13th day of November, 1974

My commission expires  
DOLORES B. COADY  
STATE NOTARY PUBLIC  
SEDGWICK COUNTY, KANSAS  
Comm. Expires Mar. 7, 1976

(Address) Notary Public.

WELL LOG

COMPANY: Donald C. Slawson  
 408 120 Building  
 Wichita, Kansas 67202

LEASE: Wade "B" #1  
 C SE SW Sec. 9-24S-23W  
 Hodgeman Co., Ks.

TOTAL DEPTH: 4800 feet

CONTRACTOR: Slawson Drilling Company, Inc.

COMMENCED: October 27, 1974

COMPLETED: November 6, 1974

CASING: Set 8 5/8" @287' w/225sx

RECEIVED  
 STATE CORPORATION COMMISSION  
 NOV 15 1974  
 CONSERVATION DIVISION  
 Wichita, Kansas

0-291	Surface hole
291-1100	Shale and Shells
1100-1226	Sand
1226-1579	Shale & Shells
1579-1601	Anhydrite
1601-2293	Shale & Shells
2293-4122	Lime and Shale
4122-4540	Lime
4540-4704	Lime and Shale
4704-4800	Lime
4800	RTD---

STATE OF KANSAS            )  
                                   )  
 COUNTY OF SEDGWICK        )    SS.

I, JAMES C. REMSBERG, of the Slawson Drilling Company, Inc. upon oath state that the above and foregoing is a true and correct copy of the log of the Wade "B" #1 well.

*James C. Remsberg*  
 \_\_\_\_\_  
 JAMES C. REMSBERG

Subscribed and sworn to before me this 13th day of November, 1974

*Dolores B. Coady*  
 \_\_\_\_\_  
 Dolores B. Coady, Notary Public

My Commission Expires:

*[Faint, illegible text at the bottom of the page]*