


STATE OF KANSAS  
STATE CORPORATION COMMISSION

WELL PLUGGING RECORD

Give All Information Completely  
Make Required Affidavit  
Mail or Deliver Report to  
Conservation Division  
State Corporation Comm.  
245 North Water  
Wichita, KS 67202

Hodgeman County, Sec. 9 Twp. 24S Rge. 23 N/W  
Location as "NE/CNW $\frac{1}{4}$ SW $\frac{1}{4}$ " or footage from lines  
NE SW

Lease Owner Tomlinson Oil Company  
Lease Name Wade Well No. 1  
Office Address Suite 1030, 200 W. Douglas, Wichita, Ks. 67202  
Character of Well (Completed as Oil, Gas or Dry Hole)  
Dry Hole

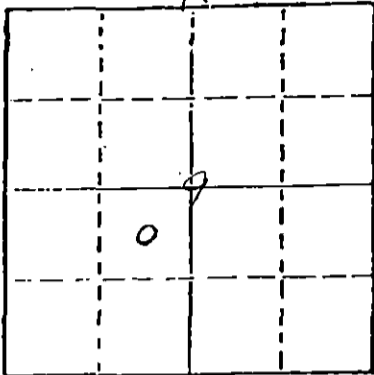

Locate well correctly on above  
Section Plot

Date Well completed Dec. 8 1977  
Application for plugging filed (verbally) Dec. 8 1977  
Application for plugging approved (verbally) Dec. 8 1977  
Plugging commenced Dec. 8 1977  
Plugging completed Dec. 8 1977

Reason for abandonment of well or producing formation  
No commercial quantity of oil or gas encountered  
If a producing well is abandoned, date of last production  
19

Was permission obtained from the Conservation Division or  
its agents before plugging was commenced? Yes

Name of Conservation Agent who supervised plugging of this well Clarence Thomas, Jr.  
Producing formation Depth to top Bottom Total Depth of Well 4740'  
Show depth and thickness of all water, oil and gas formations.

OIL, GAS OR WATER RECORDS

CASING RECORD

FORMATION	CONTENT	FROM	TO	SIZE	PUT IN	PULLED OUT

Describe in detail the manner in which the well was plugged, indicating where the mud fluid was placed and the method or methods used in introducing it into the hold. If cement or other plugs were used, state the character of same and depth placed, from feet to feet for each plug set.

Set 1st plug at 900' with 50 sacks  
2nd plug at 300' with 35 sacks  
40' solid bridge with 10 sacks  
5 sacks in rathole  
Cemented with 50/50 posmix, 6% gel  
Plug was down at 4:00 p.m., December 8, 1977.

RECEIVED  
STATE CORPORATION COMMISSION

DEC 15 1977 12-15-77

CONSERVATION DIVISION  
Wichita, Kansas

(If additional description is necessary, use BACK of this sheet)

Name of Plugging Contractor Abercrombie Drilling, Inc.

STATE OF Kansas COUNTY OF Sedgwick, ss.  
Jack L. Partridge, Ass't. Sec.-Treas. (employee of owner) or (owner or operator)  
of the above-described well, being first duly sworn on oath, says: That I have knowledge of the facts, statements, and matters herein contained and the log of the above-described well as filed and that the same are true and correct. So help me God.

(Signature)

*Jack L. Partridge*

801 Union Center, Wichita, Kansas 67202

(Address)

SUBSCRIBED AND SWORN TO before me this 13th day of December, 1977

*Sandra Richman*  
Sandra Richman Notary Public.

My commission expires July 21, 1979

