


STATE OF KANSAS
STATE CORPORATION COMMISSION
CONSERVATION DIVISION
P. O. BOX 17027
WICHITA, KANSAS 67217

FORM CP-4

WELL PLUGGING RECORD

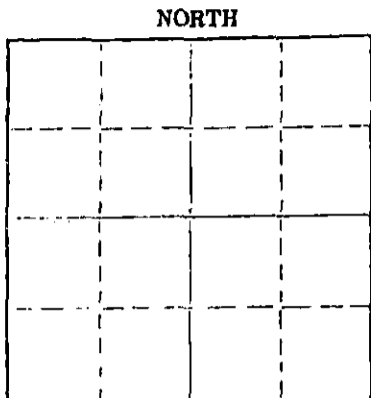

Hodgeman County, Sec. 11 Twp. 24 Rge. 23W(E) (W)
Location as "NE/CNWKSWK" or footage from lines C SW NW
Lease Owner Donald C. Slawson
Lease Name Schaffer 'I' Well No. 1
Office Address 408 120 Bldg. Wichita, Ks. 67202
Character of Well (completed as Oil, Gas or Dry Hole) Dry Hole
Date well completed May 26, 1976 19
Application for plugging filed May 26, 1976 19
Application for plugging approved May 26, 1976 19
Plugging commenced May 26, 1976 19
Plugging completed May 26, 1976 19
Reason for abandonment of well or producing formation Dry Hole

If a producing well is abandoned, date of last production 19
Was permission obtained from the Conservation Division or its agents before plugging was commenced? Yes

Name of Conservation Agent who supervised plugging of this well Clarence Thomas Garden City, KS
Producing formation Depth to top Bottom Total Depth of Well 4740 Feet
Show depth and thickness of all water, oil and gas formations.

OIL, GAS OR WATER RECORDS CASING RECORD

FORMATION	CONTENT	FROM	TO	SIZE	PULLED IN	PULLED OUT
8 5/8"	328'				328	

Describe in detail the manner in which the well was plugged, indicating where the mud fluid was placed and the method or methods used in introducing it into the hole. If cement or other plugs were used, state the character of same and depth placed, from feet to feet for each plug set.

1st plug @ 600' w/50 sx 6-7-76
2nd plug @ 300' w/35 sx
3rd plug @ 40' w/15 sx

(If additional description is necessary, use BACK of this sheet)

Name of Plugging Contractor
Address

STATE OF Kansas COUNTY OF Sedgwick
Rene M. Stucky (employee of owner) or (owner or operator) of the above-described

well, being first duly sworn on oath, says: That I have knowledge of the facts, statements, and matters herein contained and the log of the above-described well as filed and that the same are true and correct. So help me God.

(Signature) Rene M. Stucky
Rene M. Stucky (Address)

SUBSCRIBED AND SWORN TO before me this 15th day of June, 1976

My commission expires
DOLORES B. COADY
NOTARY PUBLIC
Sedgwick County, Kansas
My Appt. Exp. March 7, 1980

Dolores B. Coady
Notary Public.

WELL LOG

OPERATOR: Donald C. Slawson
 408 120 Bldg.
 Wichita, Kansas 67202

LEASE: #1 Schaffer "I"
 C SW NW Sec. 11-24-23W
 Hodgeman Co., KS.

CONTRACTOR: Slawson Drlg. Co., Inc.

COMMENCED: May 18, 1976

COMPLETED: May 26, 1976

CASING: Set 8 5/8" @ 328' w/250 sx

TOTAL DEPTH: 4740'

0 - 355	Surface Hole
355 - 1000	Sand & Shale
1000 - 1225	Sand
1225 - 1530	Shale
1530 - 1567	Anhydrite
1567 - 2188	Shale & Shells
2188 - 4740	Lime & Shale
	RTD

6-17-76
 RECEIVED
 JUN 17 1976
 CONSERVATION DIVISION
 WICHITA, KANSAS

STATE OF KANSAS)
)
 COUNTY OF SEDGWICK) SS.

I, Rene M. Stucky, of the Slawson Drilling Company, Inc. upon oath state that the above and foregoing is a true and correct copy of the log of the #1 Schaffer 'I' well.

Rene M. Stucky
 RENE M. STUCKY

Subscribed and sworn to before me this 15th day of June, 1976

Dolores B. Coady
 Dolores B. Coady, Notary Public

My commission expires:

