

STATE OF KANSAS  
STATE CORPORATION COMMISSION

WELL PLUGGING RECORD

Give All Information Completely  
Make Required Affidavit  
Mail or Deliver Report to:  
Conservation Division  
State Corporation Commission  
212 North Market, Insurance Bldg.  
Wichita, Kansas

Hodgeman

County. Sec. 18 Twp 24S Rge. 24 (E) (W)

Location as "NE/CNW/SW" or footage from lines C NE/4 SE/4

Lease Owner National Cooperative Refinery Association

Lease Name TRENT Well No. 1

Office Address 305 Rule Building, Wichita, Kansas

Character of Well (completed as Oil, Gas or Dry Hole) Dry Hole

Date well completed October 9, 19 60

Application for plugging filed October 11, 19 60

Application for plugging approved October 14, 19 60


Plugging commenced October 9, 19 60

Plugging completed October 9, 19 60

Reason for abandonment of well or producing formation Dry Hole

If a producing well is abandoned, date of last production 19

Was permission obtained from the Conservation Division or its agents before plugging was commenced? Yes

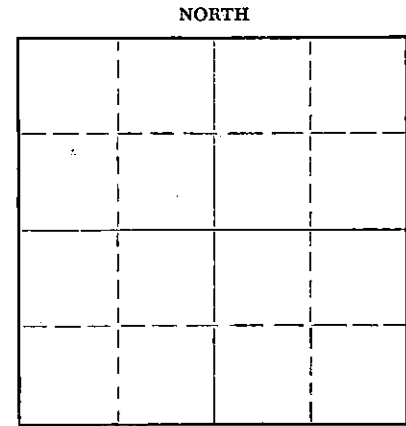

Locate well correctly on above Section Plat

Name of Conservation Agent who supervised plugging of this well Fred Hampel

Producing formation Depth to top Bottom Total Depth of Well 5065 Feet

Show depth and thickness of all water, oil and gas formations.

OIL, GAS OR WATER RECORDS

CASING RECORD

FORMATION	CONTENT	FROM	TO	SIZE	PUT IN	PULLED OUT
				8-5/8"	372'	None-Cemented

Describe in detail the manner in which the well was plugged, indicating where the mud fluid was placed and the method or methods used in introducing it into the hole. If cement or other plugs were used, state the character of same and depth placed, from feet to feet for each plug set.

Mudded hole to 300 feet. Dumped 20 sacks of cement plus 1/4 sack of hulls. Mudded hole to 35 feet, dumped 10 sacks of cement plus 1/4 sack of hulls. Filled on up to base of cellar.

10-27-60

RECEIVED  
STATE CORPORATION COMMISSION  
OCT 27 1960  
CONSERVATION DIVISION  
WICHITA, KANSAS

(If additional description is necessary, use BACK of this sheet)

Name of Plugging Contractor Gabbert-Jones Drilling, Inc.

Address 514 Orpheum Building, Wichita, Kansas

STATE OF Kansas, COUNTY OF Sedgwick, ss.  
C. R. Sears (employee of owner) or (owner/operator) of the above-described well, being first duly sworn on oath, says: That I have knowledge of the facts, statements, and matters herein contained and the log of the above-described well as filed and that the same are true and correct. So help me God.

(Signature) C. R. Sears (C. R. Sears)

305 Rule Building, Wichita, Kansas (Address)

SUBSCRIBED AND SWORN TO before me this 26th day of October, 19 60

My commission expires November 26, 1960

Nell McComb Notary Public.



