


WELL PLUGGING RECORD

Give All Information Completely
Make Required Affidavit
Mail or Deliver Report to:
Conservation Division
State Corporation Commission
211 No. Broadway
Wichita, Kansas

Gray County, Sec. 10 Twp. 24S Rge. (E) 28 (W)

Location as "NE/CNW/SW" or footage from lines C NE SW
Lease Owner Pan American Petroleum Corporation
Lease Name Brady Unit Well No. 1
Office Address Box 507 - Ulysses, Kansas
Character of Well (completed as Oil, Gas or Dry Hole) Dry Hole
Date well completed February 1 19 62
Application for plugging filed Telephone W.L.Lack- February 1 19 62
Application for plugging approved amp February 1 19 62
Plugging commenced February 1 19 62
Plugging completed February 1 19 62
Reason for abandonment of well or producing formation No commercial quantities of gas or oil
If a producing well is abandoned, date of last production None 19
Was permission obtained from the Conservation Division or its agents before plugging was commenced? Yes

NORTH

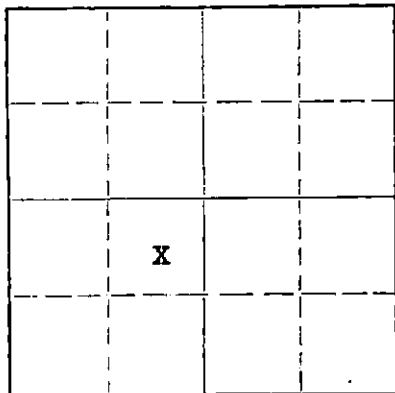

Locate well correctly on above Section Plat

Name of Conservation Agent who supervised plugging of this well Mr. W. L. Lackamp
Producing formation None Depth to top _____ Bottom _____ Total Depth of Well 3300 Feet
Show depth and thickness of all water, oil and gas formations.

OIL, GAS OR WATER RECORDS

CASING RECORD

FORMATION	CONTENT	FROM	TO ps	SIZE	PUT IN	PULLED OUT
Hollenberg			2646	10-3/4	256	None
Herrington			2684			
Winfield			2752			
Ft. Riley			2858			
Council Grove			3032			

Describe in detail the manner in which the well was plugged, indicating where the mud fluid was placed and the method or methods used in introducing it into the hole. If cement or other plugs were used, state the character of same and depth placed, from _____ feet to _____ feet for each plug set.

Rotary Mud 3300 - 600
40 sacks cement 600 - 550
rotary mud 550 - 290
30 sacks cement 290 - 240
rotary mud 240 - 30
15 sacks cement 30 - base of cellar

2-13-62
RECEIVED
STATE CORPORATION COMMISSION
FEB 1 1962
CONSERVATION DIVISION
Wichita, Kansas

(If additional description is necessary, use BACK of this sheet).

Name of Plugging Contractor Sierra Petroleum, Inc.
Address 208 Petroleum Building - Wichita, Kansas

STATE OF Kansas, COUNTY OF Grant, ss.
D. M. Liles, Area Superintendent (employee of owner) or (owner or operator) of the above-described well, being first duly sworn on oath, says: That I have knowledge of the facts, statements, and matters herein contained and the log of the above-described well as filed and that the same are true and correct. So help me God.

(Signature) [Signature]
P. O. Box 507 - Ulysses, Kansas
(Address)

SUBSCRIBED AND SWORN TO before me this 6th day of February, 19 62.

My commission expires December 3, 1964 R. W. Banks Notary Public.



PAN-AMERICAN PETROLEUM CORPORATION - Operator
SIERRA PETROLEUM COMPANY, INC. - Contractor

T. D.: 3300'
Elev.: 2748' G.L.
2757' K.B.

BRADY UNIT #1
NE SW
Sec. 10-24S-28W
Gray County, Kansas

Commenced: 1-23-62
Completed: 1-29-62

Casing:

10-3/4" Set at 265'

Cement:

with 250 sx. pozmix

FORMATION

DEPTH

Clay & Sand Streaks	110
Sand	214
Shale & Shells	425
Shale & Gyp	900
Sand & Shale	1140
Red Bed & Shale	1287
Anhydrite	1305
Shale & Sand	1490
Shale & Shells	1525
Sand	1565
Shale & Shells	2050
Cimarron Anhydrite (1862' to 1867')	
Shale & Shells	2275
Shale & Lime	2730
Lime & Shale with Chalk Streaks	2850
Lime & Shale	3300

FILED
STATE OF KANSAS COMMISSION
FEB 6 1962
CONSERVATION DIVISION
Topeka, Kansas

STATE OF KANSAS)
COUNTY OF RUSSELL) ss:

I hereby certify that the above information is true and correct to the best of my knowledge.

C. J. Hinshel

Subscribed and sworn to before me this 3rd day of February, 1962.

Leroy Ditty
Notary Public

My commission expires: 10-17-63