

15-069-00017-0000

WELL PLUGGING RECORD

FORMATION PLUGGING RECORD

Strike out upper line when reporting plugging of formations.

STATE OF KANSAS STATE CORPORATION COMMISSION

Give All Information Completely Make Required Affidavit Mail or Deliver Report to: Conservation Division State Corporation Commission 800 Bitting Building Wichita, Kansas

OR

Gray County, Sec. 18 Twp. 24 Rge. 23W(E) (W)

Location as "NE1/4NW1/4SW1/4" or footage from lines SE NW SE

Lease Owner Earl E. Wakefield et al

Lease Name Brubaker Well No. 1

Office Address 307-B Union National Bank Bldg.

Character of Well (completed as Oil, Gas or Dry Hole) Dry

Date well completed 12-31 19 45

Application for plugging filed 12-31 19 45

Application for plugging approved 12-31 19 45


Plugging commenced 12-31 19 45

Plugging completed 1-1 19 46

Reason for abandonment of well or producing formation

If a producing well is abandoned, date of last production 19

Was permission obtained from the Conservation Division or its agents before plugging was commenced? yes

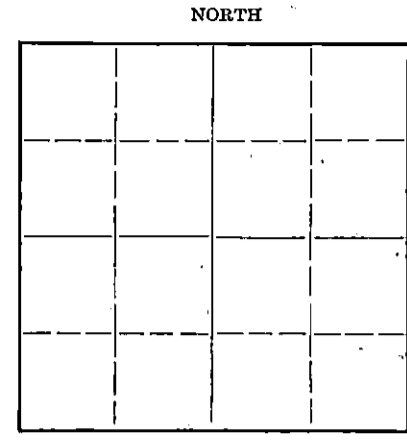

Locate well correctly on above Section Plat

Name of Conservation Agent who supervised plugging of this well H. C. Kern

Producing formation Depth to top Bottom Total Depth of Well 4953 Feet

Show depth and thickness of all water, oil and gas formations.

OIL, GAS OR WATER RECORDS

CASING RECORD

Table with 7 columns: Formation, Content, From, To, Size, Put In, Pulled Out. Contains handwritten entries for casing sizes and depths.

Describe in detail the manner in which the well was plugged, indicating where the mud fluid was placed and the method or methods used in introducing it into the hold. If cement or other plugs were used, state the character of same and depth placed, from feet to feet for each plug set.

Plug set at 275' with 18 sacks cement and filled hole with mud and one plug at 25' with cement to bottom of collar

Handwritten filing stamp: FILED 18 24 25W 39 24

Correspondence regarding this well should be addressed to Earl E. Wakefield 307-B Union National Bank Bldg. Wichita, Kansas.

STATE OF KANSAS, COUNTY OF Sedgewick, ss. Earl E. Wakefield (employee of owner) or (owner or operator) of the above-described well,

being first duly sworn on oath, says: That I have knowledge of the facts, statements, and matters herein contained and the log of the above-described well as filed and that the same are true and correct. So help me God.

(Signature) Earl E. Wakefield 307-B Union National Bank Bldg.

SUBSCRIBED AND SWORN to before me this 20th day of January 20 19 46

My commission expires 3-31-48 Notary Public.

Farm: Brubaker # 1
 Lease Owner: Earl F. Wakefield et al
 Contractor: Earl F. Wakefield
 Comm: 11-20-45 Comp: 12-31-45
 Total Depth 4953'

15-069-00017-0000

Location: NW SE
 18-24-28W
 County: Gray

CASING: 13" 245'
 8 5/8" 1151'

surface clay	40
clay	70
sand & shells	235
shale & shells	300
shale & shells	430
lime sand	510
shale & shells	630
sand	675
shale	700
lime & shale	770
shale & shells	900
shale & sand	1029
shale sandy	1266
anhydrite	1415
red bed and shale	1690
anhydrite	1719
anhydrite shale	1760
red bed and shale	1885
lime & shale	1900
lime hard	1940
anhydrite broken	2080
anhydrite	2250
shale & shells	2390
lime	2420
lime broken	2460
shale & shells	2505
red bed and shale	2560
shale & shells salt streaks	2615
shale & shells lime streaks	2697
lime and shale	2758
lime	2880
lime broken	2927
lime	3162
dolomite lime shale	3253
broken lime & shale	3323
lime broken	3406
lime	3646
lime shale	3708
shale & lime	3751
lime & shale streaks	3805
lime & shale	3988
lime	4037
lime soft	4085
lime hard	4110
lime & shale	4229
lime	4250
lime soft	4265
lime hard	4286
hard lime & chert	4303
lime	4426
lime soft	4446
lime & shale	4493
lime	4556
lime & shale	4669
shale & lime	4723
lime	4826
shale	4833
lime & shale	4850
lime chert	4869
lime & chert	4876
lime	4899
cherty lime	4905
lime hard	4951
lime cherty	4953
T.D.	

STATE OF KANSAS

COUNTY OF SEDGWICK

I hereby certify that the above is a true and correct copy of the log of the Brubaker # 1 well located in the NW SE of Section 18 Twp. 24 Range 28 W Gray County, Kansas.

Subscribed and sworn to before me this January 25th, 1945.

Notary Public

My comm. expires: 3-24-48

18 24 25W
 39 24

1-26-46

JAN 26 1946