


STATE OF KANSAS
STATE CORPORATION COMMISSION

WELL PLUGGING RECORD

Give All Information Completely
Make Required Affidavit
Mail or Deliver Report to
Conservation Division
State Corporation Comm.
245 North Water
Wichita, KS 67202

Gray County. Sec. 26 Twp. 24 Rge. 30 E/W
Location as "NE/CNW $\frac{1}{4}$ SW $\frac{1}{4}$ " or footage from lines _____

C. SE SE
Lease Owner Energy Exploration
Lease Name Irsik Well No. 1
Office Address Suite 600 1012 Baltimore Kansas City, Mo 64100
Character of Well (Completed as Oil, Gas or Dry Hole) _____

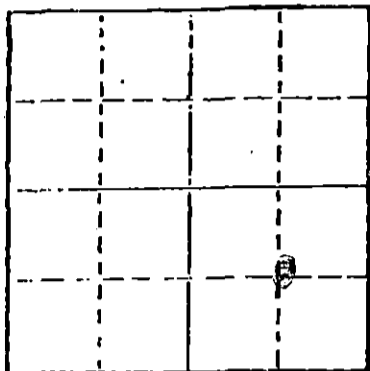

Locate well correctly on above
Section Plot

Date Well completed 1-8 1982
Application for plugging filed 1-8 1982
Application for plugging approved 1-8 1982
Plugging commenced 1-9 1982
Plugging completed 4:30 A.M. 1-9 1982

Reason for abandonment of well or producing formation _____
Dry Hole

If a producing well is abandoned, date of last production _____
19 _____

Was permission obtained from the Conservation Division or
its agents before plugging was commenced? Yes

Name of Conservation Agent who supervised plugging of this well Clarence Thomas
Producing formation _____ Depth to top _____ Bottom _____ Total Depth of Well 5110'
Show depth and thickness of all water, oil and gas formations.

OIL, GAS OR WATER RECORDS

CASING RECORD

FORMATION	CONTENT	FROM	TO	SIZE	PUT IN	PULLED OUT
Surface			475	8 5/8"	X	Left

Describe in detail the manner in which the well was plugged, indicating where the mud fluid
was placed and the method or methods used in introducing it into the hold. If cement or other
plugs were used, state the character of same and depth placed, from _____ feet to
_____ feet for each plug set.

Plugged with 70 Sx. @ 1450'
40 Sx. @ 450'
10 Sx. @ 40' to 0'
5 Sx. Rathole
Completed by Howco @ 4:30 A.M. 1-9-82

(If additional description is necessary, use BACK of this sheet)

Name of Plugging Contractor _____

STATE OF Kansas COUNTY OF Kearny, ss.
L.C. Blankenship (employee of owner) or (owner or operator)
of the above-described well, being first duly sworn on oath, says: That I have knowledge of
the facts, statements, and matters herein contained and the log of the above-described well
as filed and that the same are true and correct. So help me God.

(Signature) L.C. Blankenship

(Address) _____

SUBSCRIBED AND SWORN TO before me this 14th day of January, 1982

My commission expires 6-15-85

Nina M. Wellmaker
2-4-82
Notary Public.



RECEIVED
STATE CORPORATION COMMISSION

FFA - 4 1982

CONSERVATION DIVISION
Wichita, Kansas

RECEIVED
STATE CORPORATION COMMISSION

FFA - 4 1982

CONSERVATION DIVISION
Wichita, Kansas

CONTRACTOR'S WELL LOG

OPERATOR: Energy Exploration & Production Inc.
 CONTRACTOR: Lakin Drilling Co.
 WELL NAME: Irsik # 1
 LOCATION: C-SE-Se 26-24-30
Gray County, Kansas
 GEOLOGIST: _____
 SPUD DATE: 12-16-81
 COMPLETION DATE: 1-9-82

FOOTAGE:		
<u>0</u>	<u>375</u>	<u>Sand & Clay</u>
<u>375</u>	<u>477</u>	<u>Shale</u>
<u>477</u>	<u>1222</u>	<u>Shale</u>
<u>1222</u>	<u>2019</u>	<u>Sand & Shale-Salt</u>
<u>2019</u>	<u>2029</u>	<u>Anhy</u>
<u>2029</u>	<u>2408</u>	<u>Shale</u>
<u>2408</u>	<u>3339</u>	<u>Shale & Lime</u>
<u>3339</u>	<u>4635</u>	<u>Lime & Shale</u>
<u>4635</u>	<u>4910</u>	<u>Shale-Lime & Sd.</u>
<u>4910</u>	<u>5110</u>	<u>Cherty Lime with Shale</u>
_____	<u>5110</u>	<u>T.D.</u>
_____	_____	_____
_____	_____	_____
_____	_____	_____
_____	_____	_____

REPORT: Spud in @ 7:45 P.M. 12-16-81 12 1/4" Hole to 477'
Ran 11 Jra. 8 5/8" 23# Csg. 466.05' Set @ 475'
Cement with 300 Sx. "H" 3/8 c.c. Plug down @ 9:00 A.M. 12-17-81
By Howco
Dry Hole--Plugged with 70 Sx. @ 1450'
40 Sx. @ 450'
10 Sx. @ 40' to 0'
5 Sx. Rathole
Completed by Halliburton @ 4:30 A.M. 1-9-82

State of Kansas County of Kearny
 Louis C Blankenship, Drilling Supt for Lakin Drilling Co, does hereby state that
 the above and foregoing is a true and correct copy of the log of the Irsik # 1
lease; 26-24-30 (legal); Gray (county); Kansas.

LAKIN DRILLING COMPANY

By: *Louis C Blankenship*
 Louis C Blankenship, Drilling Supt.

Subscribed and sworn to before me, a Notary Public, in and for the aforesaid county
 and state as of this 14th day of January, 1982.



Nina M. Wellmaker
 Notary Public

My Commission Expires 6-15-85

RECEIVED
 STATE CORPORATION COMMISSION

2-4-82 FER-4 1007

CONSERVATION DIVISION
 Wichita, Kansas