

15-075-20044-0000


STATE OF KANSAS
STATE CORPORATION COMMISSION

Form CP-4

WELL PLUGGING RECORD

Give All Information Completely
Make Required Affidavit
Mail or Deliver Report to:
Conservation Division
State Corporation Commission

P. O. Box 17027
Wichita, Kansas 67217
NORTH

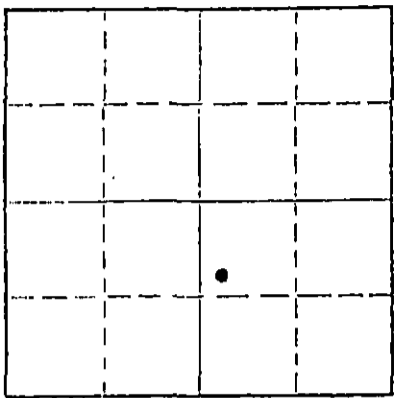

Locate well correctly on above
Section Plot

Hamilton County, Sec. 29 Twp. 24 Rge. 41 (W)
Location as "NE/CNWxSWx" or footage from lines SW NW SE
Lease Owner Home-Stake Prod. Co.
Lease Name G. T. Inge et al Well No. 1
Office Address 10th Floor Philtower Bldg, Tulsa, Oklahoma 74103
Character of Well (completed as Oil, Gas or Dry Hole) Gas
Date well completed 5-15 19 72
Application for plugging filed 5-27 19 72
Application for plugging approved 19
Plugging commenced 9-1 19 72
Plugging completed 9-3 19 72
Reason for abandonment of well or producing formation

If a producing well is abandoned, date of last production 19
Was permission obtained from the Conservation Division or its agents before plugging was commenced? Yes

Name of Conservation Agent who supervised plugging of this well Edgar Eves
Producing formation Depth to top Bottom Total Depth of Well 2410' Feet
Show depth and thickness of all water, oil and gas formations.

OIL, GAS OR WATER RECORDS

CASING RECORD

FORMATION	CONTENT	FROM	TO	SIZE	PUT IN	PULLED OUT
				8 5/8"	416'	0
				5 1/2"	2410'	1411'

Describe in detail the manner in which the well was plugged, indicating where the mud fluid was placed and the method or methods used in introducing it into the hole. If cement or other plugs were used, state the character of same and depth placed, from feet to feet for each plug set.

Plugging off bottom, pumped 100 lbs. of hulls, 300 lbs. gel mud, and 20 sacks of cement pumped with plug to 1700'.
Set plug at 420', rock 420' to 400' and run 30 sacks of cement from 400' to 310'.
Mudded from 310' to 45', rock and 10 sacks of cement from 45' to base of cellar.

9-26-72


RECEIVED
STATE CORPORATION COMMISSION
SEP 26 1972
CONSERVATION DIVISION
Wichita, Kansas

(If additional description is necessary, use BACK of this sheet)
Name of Plugging Contractor Glenn & Smith Pipe Pulling Co.
Address Box 156 Ellinwood, Kansas

STATE OF Kansas, COUNTY OF Harvey, ss.
John L. Haynes (employee of owner) or (owner or operator) of the above-described

well, being first duly sworn on oath, says: That I have knowledge of the facts, statements, and matters herein contained and the log of the above-described well as filed and that the same are true and correct. So help me God

(Signature) John L. Haynes
Burrton, Kansas (Address)

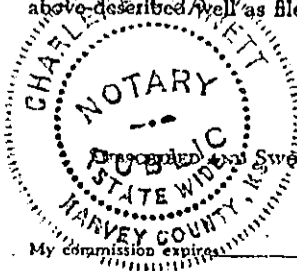

Sworn to before me this 25th day of September, 19 72.
March 19, 1973
Charlene Cornett Notary Public.

WELL LOG 15-075-20044-0000

COMPANY Home-Stake Production Company

SEC. 29 T. 24S R. 41W

FARM G. T. Inge, et al No. 1


LOC. SE NE SW

TOTAL DEPTH 2410'

COUNTY Hamilton, Kansas

COMM. 5-10-72 COMP. 5-14-72

CONTRACTOR Garvey Drilling Company

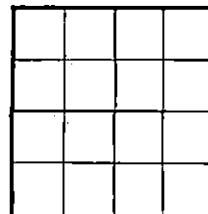

CASING

8 5/8" @ 416' w/200sx
5 1/2" @ 2409' w/225sx

ELEVATION

PRODUCTION

FIGURES INDICATE BOTTOM OF FORMATIONS

100' Sand
363' Shale
765' Red Bed & Shale
1410' Shale & Lime
2130' Lime & Shale
2410' Lime & Shale
2410' RTD

7-27-72

RECEIVED
STATE CORPORATION COMMISSION
JUL 27 1972
CONSERVATION DIVISION
Wichita, Kansas

State of Kansas }
County of Barton } ss

I, Charlene Marker of Garvey Drilling Company

upon oath state the above and foregoing is a true and correct copy of the log of the G. T. Inge, et al No. 1 well.

Charlene Marker

Subscribed and sworn to before me this 16th day of May 1972

My Commission Expires: July 8, 1974

[Signature]
NOTARY PUBLIC