

STATE OF KANSAS
STATE CORPORATION COMMISSION
200 Colorado Derby Building
Wichita, Kansas 67202

WELL PLUGGING RECORD
K.A.R.-82-3-117

15-047-19042-0000

API NUMBER Unknown

LEASE NAME Cudney

WELL NUMBER A-1

 Ft. from S Section Line

 Ft. from E Section Line

SEC. 27 TWP. 25 SRGE. 16 (W)

COUNTY Edwards

Date Well Completed unknown

Plugging Commenced 12-6-85

Plugging Completed 12-19-85

TYPE OR PRINT
NOTICE: Fill out completely
and return to Cons. Div.
office within 30 days.

LEASE OPERATOR LASMO Energy Corporation

ADDRESS Box 1365, Great Bend, Kansas 67530

PHONE#(316) 792-2585 OPERATORS LICENSE NO. 4678

Character of Well Oil

(Oil, Gas, D&A, SWD, Input, Water Supply Well)

Did you notify the KCC/KDHE Joint District Office prior to plugging this well? yes

Which KCC/KDHE Joint Office did you notify? Dist. #1

Is ACO-1 filed? yes If not, is well log attached?

Producing Formation Depth to Top 4388 Bottom 4458 T.D. 4552

Show depth and thickness of all water, oil and gas formations.

OIL, GAS OR WATER RECORDS

CASING RECORD

Formation	Content	From	To	Size	Put in	Pulled out
				8 5/8	395	0
				5 1/2	4551	2153

Describe in detail the manner in which the well was plugged, indicating where the mud fluid was placed and the method or methods used in introducing it into the hole. If cement or other plugs were used, state the character of same and depth placed, from feet to feet each set.

Bottom plug - pumped 100# Hulls-30 Sks. common cement to 4200'

Top plug 3 Hulls, 15 gel-60 Sks 60-40 pos-mix 6% gel, 10 gel, 1 Hull

8 5/8 plug 110 sks cement

(If additional description is necessary, use BACK of this form.)

Name of Plugging Contractor Great Bend Casing Pullers, Inc. License No. 4639CP

Address Box 458, Great Bend, Kansas 67530

STATE OF Kansas COUNTY OF Barton, ss.

Wesley Siroky (Employee of Operator) or (Operator) of above-described well, being first duly sworn on oath, says: That I have knowledge of the facts, statements, and matters herein contained and the log of the above-described well as filed that the same are true and correct, so help me God.


(Signature) Wesley Siroky

(Address) Box 768, Great Bend, Ks. 67530

SUBSCRIBED AND SWORN TO before me this 19th day of December, 19 85

Carmen R Cook
Notary Public

My Commission Expires: 12-12-86

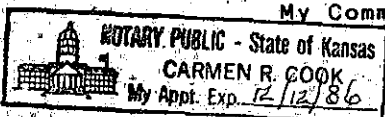

RECEIVED
STATE CORPORATION COMMISSION

Form CP-4
Revised 08-84

12-20-85 DEC 20 1985

WELEX



PERFORATING RECORD

6-0
C

COMPANY RT Reeper
 WELL Cudney #1
 FIELD Wil Pool
 County Edwards
 State KANSAS
 File

COMPANY RT Reeper *LASMO Energy Corp.*
 WELL Cudney #1
 FIELD Wil Pool
 COUNTY Edwards STATE KANSAS

Location C-SE-SE
 Other Logs
 Sec. 27 Twp. 25S Rge. 16W
 Elevation

Permanent Datum 8' Above G.L. Elev. 2068
 Log Measured From 8' Above G.L.
 Drilling Measured From Kelly Logging
 KB. 2068
 DF. 2065
 GL. 2060

CASING COLLARS AT		PERFORATED ZONES	
		Interval	No. of Holes
		from	
		to	
		from	
		to	
		from	
		to	
		from	
		to	
		from	
		to	

The above depths refer to:
 Welex Measurement
 Drillers Measurement
 Others

CASING RECORD					
Size-in	Wt.-lbs.	Interval		Drillers T.D.	
<u>5 1/2</u>	<u>14</u>	from <u>4551</u>	to <u>0</u>	<u>4510</u>	
		from	to	<u>4513</u>	
		from	to		

Remarks

STATE CORPORATION COMMISSION

Rup. No. 210 Recorded By Rd Spook
 Date 5-13-60 Witnessed By Mike Cain

11-12-85

RECEIVED CORPORATION COMMISSION

NOV 12 1960

PERFORATING DIVISION Wichita, Kansas