

WELL PLUGGING RECORD

Give All Information Completely:
Make Required Affidavit
Mail or Deliver Report to:
Conservation Division
State Corporation Commission
212 North Market, Insurance Bldg.
Wichita, Kansas

Grant

County. Sec. 36 Twp. 27S Rge. 35W (E) (W)

Location as "NE/CNW/SW" or footage from lines SE SE

Lease Owner R. W. Lange

Lease Name Pollyana

Well No. 1

Office Address Box 1034, Garden City, Kansas

Character of Well (completed as Oil, Gas or Dry Hole)

Date well completed 11/21 19 59

Application for plugging filed 2/4 19 64

Application for plugging approved 2/6 19 64


Plugging commenced 2/8 19 64

Plugging completed 2/12 19 64

Reason for abandonment of well or producing formation Depleted

If a producing well is abandoned, date of last production 19

Was permission obtained from the Conservation Division or its agents before plugging was commenced? Yes

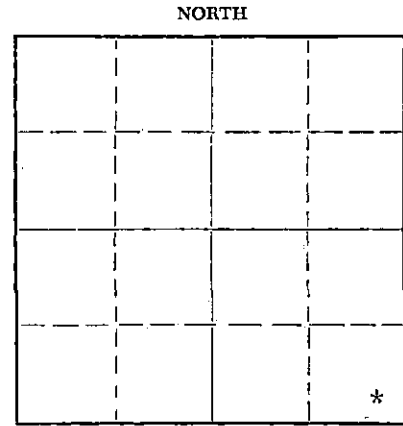

Locate well correctly on above Section Plat

Name of Conservation Agent who supervised plugging of this well Hugh Scott

Producing formation Lansing Depth to top 4134 Bottom 4142 Total Depth of Well 5659 Feet

Show depth and thickness of all water, oil and gas formations.

OIL, GAS OR WATER RECORDS

CASING RECORD

FORMATION	CONTENT	FROM	TO	SIZE	PUT IN	PULLED OUT
				85/8	670	none
				51/2	4650	none

Describe in detail the manner in which the well was plugged, indicating where the mud fluid was placed and the method or methods used in introducing it into the hole. If cement or other plugs were used, state the character of same and depth placed, from feet to feet for each plug set.

Mix 20 sax of cement and pump plug to 2829' (2829' to 2929' cement). Could not recover any casing. Mud to 550' and pump 10 sacks of cement 550' to 650'. Mud to 50' and 5 sacks cement 50' to 0'. Cut casing off three feet below ground level and weld cap on same.

7-14-64

RECEIVED
STATE CORPORATION COMMISSION

JUL 14 1964

CONSERVATION DIVISION
Wichita, Kansas

(If additional description is necessary, use BACK of this sheet)

Name of Plugging Contractor Sargent's Casing Pulling Service

Address Box 506 Liberal, Kansas

STATE OF _____, COUNTY OF _____, ss.

(employee of owner) or (owner or operator) of the above-described well, being first duly sworn on oath, says: That I have knowledge of the facts, statements, and matters herein contained and the log of the above-described well as filed and that the same are true and correct. So help me God.

(Signature) R. W. Lange

(Address)

SUBSCRIBED AND SWORN TO before me this 13th day of July, 1964

Georgia C. Brewa
Notary Public.

My commission expires January 25, 1966



LEASE: POLLYANNA #1
 OPERATOR: PLEASANT PRAIRIE OILS INC.
 CONTRACTOR: EARL F. WAKEFIELD
 COMM: 8/10/59 COMP: 8/31/59

LOCATION: C SE SE
 SECTION 36-27S-35W
 GRANT COUNTY, KANSAS
 CASING: 8 5/8" Set at 675 feet
 5 1/2" Set at 4672 feet

ELEVATION _____

Clay Sand	130
Sand Shale	606
Blue Gum	675
Red Bed	900
Red Bed and Sand	1700
Red Bed Sand and Shells	1965
Shale and Salt	2291
Lime and Shells	2412
Lime and Shale	2533
Shale and Anhydrite	2626
Lime and Shale	2745
Shale and Lime	2840
Lime and Shale	2939
Shale, Red Bed and Shells	3025
Lime	3098
Lime and Shale	3619
Lime and Sand	3726
Lime and Shale	3825
Lime	3899
Lime and Shale	3926
Lime	3980
Lime and Shale	4048
Lime	4128
Lime and Sand	4150
Lime	4290
Lime and Shale	4355
Lime	4702
Lime and Sand	4779
Lime	4804
Lime and Shale	4880
Lime	4919
Lime and Shale	5039
Cherty Lime	5124
Chert and Lime	5159
Cherty Lime	5198
Sand and Lime	5235
Lime and Shale	5274
Shale and Lime	5320
Shale	5385
Chester	5411
Lime	5702
Lime and Chalk	5710
T.D.	5710

7-14-64
RECEIVED
 STATE CORPORATION COMMISSION
 JUL 14 1964
 CONSERVATION DIVISION
 Wichita, Kansas

STATE OF KANSAS)
) ss
 COUNTY OF SEDGWICK)

I hereby certify that the above is a true and correct copy of the log on the Pollyanna #1 well, located C SE SE of Section 36-27S-35W, Grant County, Kansas.

EARL F. WAKEFIELD

By Earl F. Wakefield

Subscribed and sworn before me this 9th day of September, 1959.



C. A. Snow
 NOTARY PUBLIC

My Commission expires July 26, 1962.