


WELL PLUGGING RECORD

Give All Information Completely
Make Required Affidavit
Mail or Deliver Report to:
Conservation Division
State Corporation Commission
800 Bittling Building
Wichita, Kansas

NORTH

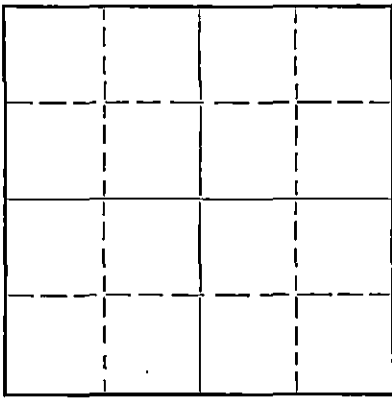

Locate well correctly on above Section Flat

Grant _____ County. Sec. 36 Twp. 27 Rge. 35 (E) (W)
Location as "NE/CNW $\frac{1}{4}$ /SW $\frac{1}{4}$ " or footage from lines C. NW SE
Lease Owner Rock Island Oil & Refining Co., Inc.
Lease Name Appleman Well No. B-1
Office Address 321 W. Douglas, Wichita, Kansas
Character of Well (completed as Oil, Gas or Dry Hole) Dry Hole
Date well completed March 9 19 66
Application for plugging filed March 9 19 66
Application for plugging approved March 9 19 66
Plugging commenced March 9 19 66
Plugging completed March 9 19 66
Reason for abandonment of well or producing formation formation nonproductive

If a producing well is abandoned, date of last production _____ 19____
Was permission obtained from the Conservation Division or its agents before plugging was commenced? yes

Name of Conservation Agent who supervised plugging of this well E. J. Eves
Producing formation _____ Depth to top _____ Bottom _____ Total Depth of Well 4190 Feet
Show depth and thickness of all water, oil and gas formations.

OIL, GAS OR WATER RECORDS

CASING RECORD

Formation	Content	From	To	Size	Put In	Pulled Out
				8 5/8"	648	-0-

Describe in detail the manner in which the well was plugged, indicating where the mud fluid was placed and the method or methods used in introducing it into the hole. If cement or other plugs were used, state the character of same and depth placed, from _____ feet to _____ feet for each plug set.

Conditioned mud and circulated hole. Set 35 sx. cement plug at 700'. Set second plug at 40' with 15 sx. cement. Cut off 8 5/8" 3' below surface and welded cap on top of cut off pipe.

First Plug at 700'. From 700' to 805'.
Second Plug at 40'. From 40' to 82'.

RECEIVED
STATE CORPORATION COMMISSION

APR 18 1966

CONSERVATION DIVISION
Wichita, Kansas

(If additional description is necessary, use BACK of this sheet)

Correspondence regarding this well should be addressed to Murfin Drilling Co.
Address Wichita, Kansas

STATE OF Kansas, COUNTY OF Sedgwick, ss.
T. D. Ables _____ (employee of owner) or (owner or operator) of the above-described well,

being first duly sworn on oath, says: That I have knowledge of the facts, statements, and matters herein contained and the log of the above-described well as filed and that the same are true and correct. So help me God.

(Signature) T. D. Ables

321 W. Douglas, Wichita, Kansas
(Address)

SUBSCRIBED AND SWORN TO before me this 15 day of April, 19 66

My commission expires December 8, 1969

Janice Lee
Janice Lee-- Notary Public.



WELL LOG

Operator: Rock Island Oil & Refining Co., Inc.
 Lease: Appleman Well No.: B-1
 Location: C. NW SE, Sec. 36, T. 27S, R. 35W, Grant Co., Kansas
 Contractor: Murfin Drilling Co.
 Commencement: March 1, 1966 Completion: March 9, 1966
 Total Depth: 4190' K.B.
 Classification: Dry Hole

Surface Clay and Sand	0'- 408'
Shale	408'- 651'
Shale, Shells, Sand	651'-1085'
Shale	1085'-1410'
Sand	1410'-1570'
Shale	1570'-1895'
Anhydrite and Shale	1895'-2045'
Shale	2045'-2570'
Lime and Shale	2570'-3075'
Lime	3075'-3265'
Lime and Shale	3265'-4110'
Lime	4110'-4190'
RTD	4190'

RECEIVED
STATE CORPORATIONS COMMISSION

APR 18 1966

CONSERVATION DIVISION
Wichita, Kansas

State of Kansas
 County of Sedgwick) SS:

I, T. D. Ables of Rock Island Oil & Refining Co., Inc.

upon oath state that the above and foregoing is a true and correct copy of the log of the Appleman 'B' #1 well .

T. D. Ables

Subscribed and sworn to before me this 15th day of April 19 66.

My Commission Expires: Dec. 8, 1969

Janice Lee
 Janice Lee Notary Public
 Lee