


STATE OF KANSAS
STATE CORPORATION COMMISSION
200 Colorado Derby Bldg.
Wichita, Kansas 67202

Form CP-4
Rev. 12-15-80

WELL PLUGGING RECORD

Give All Information Completely
Make Required Affidavit

COUNTY Edwards SEC. 30 TWP. 25S RGE. 16W E/W
Location as in quarters or footage from lines:
25' E of C N/2 SW NW

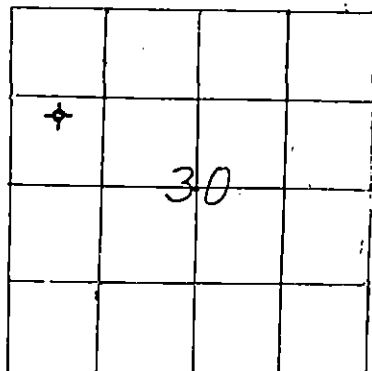

Locate Well
correctly on above
Section Platt.

Lease Owner D. R. Lauck Oil Company, Inc.
Lease Name Parker "C" Well No. 1
Office Address 221 S. Broadway, Suite 400, Wichita, Kansas 67202
Character of Well (Completed as Oil, Gas or Dry Hole): Dry Hole
Date Well Completed 1/26/82
Application for plugging filed 2/4/82
Plugging commenced 1/26/82
Plugging completed 1/26/82
Reason for abandonment of well or producing formation Dry Hole

Was permission obtained from the Conservation Division or it's
Agent's before plugging was commenced? Yes

Name of Conservation Agent who supervised plugging of this well Paul Luthi
Producing formation _____ Depth to top _____ bottom _____ T.D. 4565'
Show depth and thickness of all water, oil and gas formations.

OIL, GAS OR WATER RECORDS Casing Record

Formation	Content	From	To	Size	Put in	Pulled Out
		0'	145'	12-3/4"	150.91'	None
		0'	383'	8-5/8"	376.26'	None

Describe in detail the manner in which the well was plugged, indicating where the mud
fluid was placed and the method or methods used in introducing it into the hold. If cement
or other plugs were used, state the character of same and depth placed, from _____ feet
to _____ feet for each plug set.

2-5-82
Plugged with 40 sacks cement at 900';
plug and 35 sacks cement at 360';
bridge plug and 10 sacks cement at 40';
and 10 sacks cement in rat hole.

RECEIVED
STATE CORPORATION COMMISSION
FEB - 5 1982
CONSERVATION DIVISION
Wichita, Kansas

(If additional description is necessary, use BACK of this sheet)
Name of Plugging Contractor Allied Cementing Co.


STATE OF KANSAS COUNTY OF SEDGWICK, ss.
John D. Knightley (employee of owner) or (owner or operator) of the
above-described well, being first duly sworn on oath, says: That I have knowledge of the
facts, statements, and matters herein contained and the log of the above-described well as
filed and that the same are true and correct. So help me God.

(Signature) [Signature]
221 S. Broadway, Wichita, KS 67202
(Address)

SUBSCRIBED AND SWORN TO before me this 4th day of February, 19 82

Stella J. Lipps
Notary Public.

My Commission expires: March 12, 1983

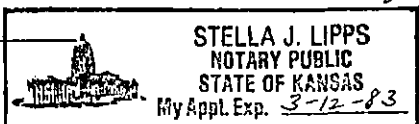

13-047-21003-0000

D. R. Lauck Oil Company, Inc. - Parker "C" #1,
221 S. Broadway, Suite 400 25' East of N/2 SW NW
Wichita, Kansas 67202 Sec. 30-25S-16W
 Edwards County, Kansas

Contractor: D. R. Lauck Oil Company, Inc.
 221 S. Broadway, Suite 400
 Wichita, Kansas 67202

Commenced: January 15, 1982
Completed: January 26, 1982

Drillers Log

Sand	125
Shale	195
Sand	250
Shale, Sand, Shale	360
Sand	389
Sand, Red Bed & Shale	586
Shale	3790
Shale & Lime	4135
Lime & Shale	4280
Shale & Lime	4410
Lime & Shale	4466
Lime	4565 RTD

RECEIVED
STATE CORPORATION COMMISSION
FEB - 5 1982
CONSERVATION DIVISION
Wichita, Kansas