

Give All Information Completely  
Make Required Affidavit  
Mail or Deliver Report to:  
Conservation Division  
State Corporation Commission  
211 No. Broadway  
Wichita, Kansas


**RECEIVED**  
JUL 13 1962

**WELL PLUGGING RECORD**

**INGER OIL CO.**

Edwards County, Sec. 34 Twp. 25 Rge. 16 (E) W (W)

Location as "NE/CNW/SW" or footage from lines. SW SW NE  
Lease Owner: Inger Oil Company  
Lease Name: Henshaw Well No. 12  
Office Address: Wichita, Kansas  
Character of Well (completed as Oil, Gas or Dry Hole) \_\_\_\_\_  
Date well completed \_\_\_\_\_ 19\_\_\_\_  
Application for plugging filed \_\_\_\_\_ 19\_\_\_\_  
Application for plugging approved \_\_\_\_\_ 19\_\_\_\_  
Plugging commenced 6-29-62 \_\_\_\_\_ 19\_\_\_\_  
Plugging completed 7-5-62 \_\_\_\_\_ 19\_\_\_\_  
Reason for abandonment of well or producing formation Depleted.

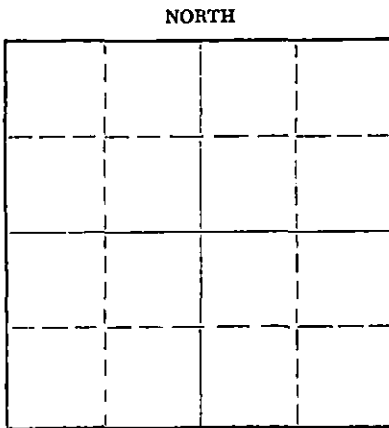

Locate well correctly on above  
Section Plat

If a producing well is abandoned, date of last production \_\_\_\_\_ 19\_\_\_\_  
Was permission obtained from the Conservation Division or its agents before plugging was commenced? yes

Name of Conservation Agent who supervised plugging of this well Justice  
Producing formation \_\_\_\_\_ Depth to top \_\_\_\_\_ Bottom \_\_\_\_\_ Total Depth of Well 4442 Feet  
Show depth and thickness of all water, oil and gas formations.

**OIL, GAS OR WATER RECORDS**

**CASING RECORD**

FORMATION	CONTENT	FROM	TO	SIZE	PBT IN	PULLED OUT
				8-5/8"	400'	None
				5-1 1/2"	4469'	3018'

Describe in detail the manner in which the well was plugged, indicating where the mud fluid was placed and the method or methods used in introducing it into the hole. If cement or other plugs were used, state the character of same and depth placed, from \_\_\_\_\_ feet to \_\_\_\_\_ feet for each plug set.

Checked hole to 4050', ran 20 gal. of sand to 4030' and dumped 5 sacks of cement @ 4030' with dump bailer. Pulled 5 1/2" casing, checked fluid @ 30'. Set rock bridge @ 300' and dumped 12 sacks of cement on bridge with dump bailer. Bailed fluid to 280' and ran 13 sacks of cement. Mudded to 35', set rock bridge to 30' and ran 10 sacks of cement to base of cellar.

7-17-62

**RECEIVED**  
STATE CORPORATION COMMISSION

PLUGGING COMPLETE.

JUL 17 1962

CONSERVATION DIVISION  
Wichita, Kansas

(If additional description is necessary, use BACK of this sheet)

Name of Plugging Contractor KNIGHT CASING PULLING COMPANY  
Address CHASE, KANSAS

STATE OF KANSAS, COUNTY OF RICE, ss.  
Noel J. Knight (employee of owner) or (owner/representative) of the above-described well, being first duly sworn on oath, says: That I have knowledge of the facts, statements, and matters herein contained and the log of the above-described well as filed and that the same are true and correct. So help me God.


(Signature) Noel J. Knight  
Chase, Kansas  
(Address)

SUBSCRIBED AND SWORN to before me this 12th day of July, 1962

My commission expires May 20, 1964

Milton J. Volin  
Notary Public.

COPY

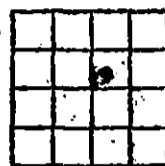WELL LOG BUREAU—KANSAS GEOLOGICAL SOCIETY  
508 East Murdock, Wichita, KansasCompany- L. C. SMITHERMAN-OIL PRODUCER  
Farm- Hinshaw No. 2SEC. 34 T. 25 R. 16W  
SW SW NETotal Depth. 4469'  
Comm. 8-18-58 Comp. 9-4-58  
Shot or Treated.  
Contractor. L. C. Smitherman Drilling Co.  
Issued. 9-24-60County Edwards  
KANSAS

Elevation. 2066' RB

Production. 29 BOPD

## CASING:

8 5/8" @ 411' w/250 sks. cem.  
5 1/2" @ 4487' w/100 sks. cem.

Figures indicate Bottom of Formations.

sand	106
sand & shale	300
shale	400
shale & red bed	1120
shale	1928
shale & lime	2130
lime	2285
lime & shale	3014
shale	3140
shale & lime strks.	3207
lime & shale	3950
lime	3985
lime & shale	4060
lime	4120
lime & shale strks.	4209
lime & shale	4420
lime & chert	4430
chert	4459
chert & sand	4469
Total Depth	

SCOUT TOPS:

Hoebner	3750
Toronto	3768
Douglas	3789
Brown Lime	3881
Lansing	3906
Base Kansas City	4164
Fort Scott	4350
Cherokee Sand	4364
Conglomerate	4393
Mississippi	4418
Kinderhook Shale	4445
Kinderhook Sand	4461

RECEIVED  
JUN 30 1962

INGER OIL CO.

7-3-62  
RECEIVED  
STATE CORPORATION COMMISSIONJUL 3 1962  
CONSERVATION DIVISION  
Wichita, Kansas