


STATE OF KANSAS
STATE CORPORATION COMMISSION

WELL PLUGGING RECORD

Give All Information Completely
Make Required Affidavit
Mail or Deliver Report to
Conservation Division
State Corporation Comm.
245 North Water
Wichita, KS 67202

Edwards County. Sec. 24 Twp. 24S Rge. 17W E/W
Location as "NE/CNW 1/4 SW 1/4" or footage from lines
440' ENL. & 440' FWL NW/4.
Lease Owner F.C. Holl
Lease Name Keller Well No. 1-24
Office Address 6427 East Kellogg Wichita, Ks. 67207
Character of Well (Completed as Oil, Gas or Dry Hole) _____

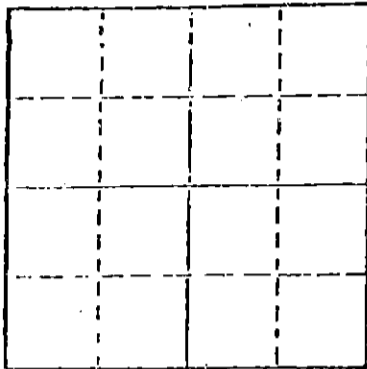

Locate well correctly on above
Section Plot

Date Well completed _____ 19____
Application for plugging filed _____ 19____
Application for plugging approved _____ 19____
Plugging commenced 8-24-81 19____
Plugging completed 8-26-81 19____
Reason for abandonment of well or producing formation _____

Depleted
If a producing well is abandoned, date of last production _____ 19____

Was permission obtained from the Conservation Division or its agents before plugging was commenced? yes

Name of Conservation Agent who supervised plugging of this well Maurice Leslie
Producing formation _____ Depth to top _____ Bottom _____ Total Depth of Well 4480'
Show depth and thickness of all water, oil and gas formations.

OIL, GAS OR WATER RECORDS

CASING RECORD

FORMATION	CONTENT	FROM	TO	SIZE	PUT IN	PULLED OUT
				8-5/8"	254'	none
				4-1/2"	4477'	2436'

Describe in detail the manner in which the well was plugged, indicating where the mud fluid was placed and the method or methods used in introducing it into the hold. If cement or other plugs were used, state the character of same and depth placed, from _____ feet to _____ feet for each plug set.

Moved in on location, ran sand to 4300' and set 4 sacks cement, pulled 18 1/2" tension
Shot pipe @3340', 3210', 3020', 2820', 2615', and 2420'. Pulled 74 joints of pipe.
Plugged well with 15 sacks gel, 6 sacks hulls, 10 sacks gel, 8-5/8" plug, 125 sacks
50/50 pos, 4% gel, 3% cc. Plugging completed.

RECEIVED

STATE CORPORATION COMMISSION

AUG 30 1981

(If additional description is necessary, use BACK of this sheet)

Name of Plugging Contractor Kelso Casing Pulling CONSERVATION DIVISION
Wichita, Kansas

STATE OF Kansas COUNTY OF Rice, ss.
R. Darrell Kelso (employee of owner) or (owner or operator)
of the above-described well, being first duly sworn on oath, says: That I have knowledge of the facts, statements, and matters herein contained and the log of the above-described well as filed and that the same are true and correct. So help me God.

(Signature) R. Darrell Kelso
R. Darrell Kelso
(Address)

SUBSCRIBED AND SWORN TO before me this 28th day of August, 19 81



My commission expires _____

RECEIVED
STATE CORPORATION COMMISSION
AUG 31 1981
Notary Public.
CONSERVATION DIVISION
Wichita, Kansas
8-31-81