

15-047-20754-0000

STATE OF KANSAS
STATE CORPORATION COMMISSION

WELL PLUGGING RECORD

Give All Information Completely
Make Required Affidavit
Mail or Deliver Report to
Conservation Division
State Corporation Comm.
245 North Water
Wichita, KS 67202

Edwards County. Sec. 11 Twp. 24S Rge. 18W E/W
Location as "NE/CNW $\frac{1}{4}$ /SW $\frac{1}{4}$ " or footage from lines _____


N/2 NW NE
Lease Owner Hummon Corporation
Lease Name Wolfe Well No. 1

Office Address 400 One Main Place, Wichita, KS 67202
Character of Well (Completed as Oil, Gas or Dry Hole) _____
Dry Hole

Date Well completed December 16, 1980
Application for plugging filed December 16, 1980
Application for plugging approved December 16, 1980
Plugging commenced December 16, 1980
Plugging completed December 16, 1980

Reason for abandonment of well or producing formation _____
Dry hole.

If a producing well is abandoned, date of last production _____ 19____
Was permission obtained from the Conservation Division or its agents before plugging was commenced? Yes

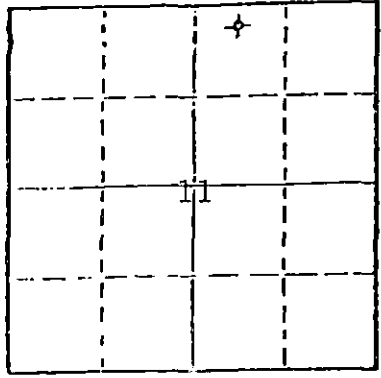

Locate well correctly on above Section Plat

Name of Conservation Agent who supervised plugging of this well Rankin
Producing formation _____ Depth to top _____ Bottom _____ Total Depth of Well 4550'
Show depth and thickness of all water, oil and gas formations.

OIL, GAS OR WATER RECORDS

CASING RECORD

FORMATION	CONTENT	FROM	TO	SIZE	PUT IN	PULLED OUT
		0'	297'	8-5/8"	290.27'	None

Describe in detail the manner in which the well was plugged, indicating where the mud fluid was placed and the method or methods used in introducing it into the hold. If cement or other plugs were used, state the character of same and depth placed, from _____ feet to _____ feet for each plug set.

Pumped all mud from pits into hole;
Squeezed 150 sacks cement on top of mud,
authority given by State Pluggger Rankin.
10 sacks cement in rat hole.

(If additional description is necessary, use BACK of this sheet)

Name of Plugging Contractor Allied Cementing Co.

STATE OF KANSAS COUNTY OF SEDGWICK, ss.
John D. Knightley, Agent (employee of owner) or (owner or operator)
of the above-described well, being first duly sworn on oath, says: That I have knowledge of the facts, statements, and matters herein contained and the log of the above-described well as filed, and that the same are true and correct. So help me God.



(Signature) [Signature]
221 S Broadway, Wichita, Kansas 67202
(Address)

SUBSCRIBED AND SWORN TO before me this 8th day of January, 19 81

Stella J. Lipps Notary Public.

My commission expires March 12, 1983

RECEIVED 1-15-81
STATE CORPORATION COMMISSION

JAN 15 1981
CONSERVATION DIVISION
Wichita, Kansas

15-047-20754-0000

Hummon Corporation - Wolfe #1
400 One Main Place N/2 NW NE Sec. 11-24S-18W
Wichita, Kansas 67202 Edwards County, Kansas

Contractor: D. R. Lauck Oil Company, Inc.
221 S. Broadway, Suite 400
Wichita, Kansas 67202

Commenced: December 7, 1980
Completed: December 16, 1980

Drillers Log

Sand	100
Red Bed	160
Blue Shale	300
Red Bed	675
Sand	720
Shale	930
Shale & Shells	1178
Anhydrite	1195
Shale & Shells	3490
Shale & Lime	4015
Lime	4462
Lime & Sand	4530
Lime & Chert	4550 RTD