

15-047-20258-0000


STATE OF KANSAS
STATE CORPORATION COMMISSION

WELL PLUGGING RECORD

Give All Information Completely
Make Required Affidavit
Mail or Deliver Report to
Conservation Division
State Corporation Comm.
245 North Water
Wichita, KS 67202

Edwards County. Sec. 6 Twp. 21S Rge. 19W E/W
Location as "NE/CNW $\frac{1}{4}$ SW $\frac{1}{4}$ " or footage from lines
C NW NW

Lease Owner Sterling Drilling Company, et al
Lease Name Herrmann "G" #1 Well No. 1
Office Address P. O. Box 129, Sterling, Kansas 67579
Character of Well (Completed as Oil, Gas or Dry Hole)
Dry Hole

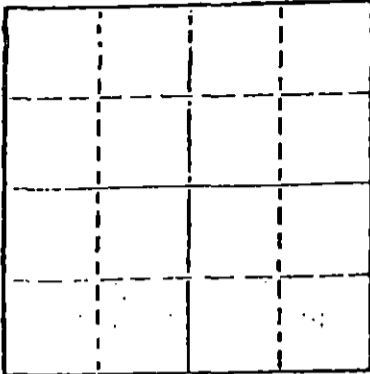

Locate well correctly on above
Section Plot

Date Well completed May 25, 1977 19
Application for plugging filed May 24, 1977 19
Application for plugging approved May 24, 1977 19
Plugging commenced 5:00 AM, May 25, 1977 19
Plugging completed 7:00 AM, May 25, 1977 19
Reason for abandonment of well or producing formation
Dry Hole

If a producing well is abandoned, date of last production 19

Was permission obtained from the Conservation Division or
its agents before plugging was commenced? Yes

Name of Conservation Agent who supervised plugging of this well J. H. Metz
Producing formation _____ Depth to top _____ Bottom _____ Total Depth of Well 3011'
Show depth and thickness of all water, oil and gas formations.

OIL, GAS OR WATER RECORDS

CASING RECORD

FORMATION	CONTENT	FROM	TO	SIZE	PUT IN	PULLED OUT
				8 5/8"	259'	None

Describe in detail the manner in which the well was plugged, indicating where the mud fluid was placed and the method or methods used in introducing it into the hold. If cement or other plugs were used, state the character of same and depth placed, from _____ feet to _____ feet for each plug set.

Filled hole with heavy mud.
First plug at 240', 35 sacks cement.
Mud to 40' with plug and 1/2 sack hulls;
12 sacks cement to surface;
2 sacks in Mousehold; 3 sacks in Rathole.

RECEIVED
STATE CORPORATION COMMISSION
MAY 27 1977
5-27-77
CONSERVATION DIVISION
Wichita, Kansas

(If additional description is necessary, use BACK of this sheet)

Name of Plugging Contractor Sterling Drilling Company, P. O. Box 129, Sterling, Kansas 67579

STATE OF KANSAS COUNTY OF RICE, ss.
F. A. Wuellner (employee of owner) or (owner or operator)
of the above-described well, being first duly sworn on oath, says: That I have knowledge of the facts, statements, and matters herein contained and the log of the above-described well as filed and that the same are true and correct. So help me God. STERLING DRILLING COMPANY


(Signature) F. A. Wuellner
F. A. Wuellner, Secretary
P. O. Box 129, Sterling, Kansas 67579
(Address)

SUBSCRIBED AND SWORN TO before me this 26th day of May, 19 77

CHARLES HALL—NOTARY PUBLIC
My Commission Expires Jan. 6, 1978

Charles M. Hall
Charles M. Hall, Notary Public.

My commission expires

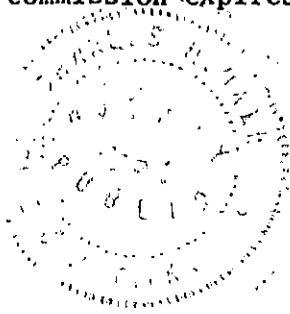

15-047-20258-0000

STERLING DRILLING COMPANY
P. O. Box 129
Sterling, Kansas 67579

WELL LOG ----- HERRMANN G-1
Located: C NW NW, Section 6-24S-19W, Edwards County, Kansas

OWNER: Sterling Drilling Company, et al
ROTARY DRILLING CONTRACTOR: Sterling Drilling Company

COMMENCED: May 21, 1977
COMPLETED: May 25, 1977

TOTAL DEPTH: 3011'

<u>LOG</u>		<u>CASING RECORD</u>
0 - 261	Sand and Shale	Ran 6 joints 8 5/8" casing, 246.33' set at 259 K.B. Cemented with 225 sacks 50/50 Pozmix, 3% cc. Plug down at 2:30 PM, 5-21-77.
261 - 1378	Shale	
1378 - 1395	Anhydrite	
1395 - 1940	Shale	
1940 - 3011	Lime and Shale	Plugged.

RECEIVED
STATE GEOLOGICAL COMMISSION
MAY 27 1977 5-27-77
CONSERVATION DIVISION
Wichita, Kansas