


15-047-20178-0000

STATE OF KANSAS
STATE CORPORATION COMMISSION
CONSERVATION DIVISION
P. O. BOX 17027
WICHITA, KANSAS 67217

FORM CP-4

WELL PLUGGING RECORD

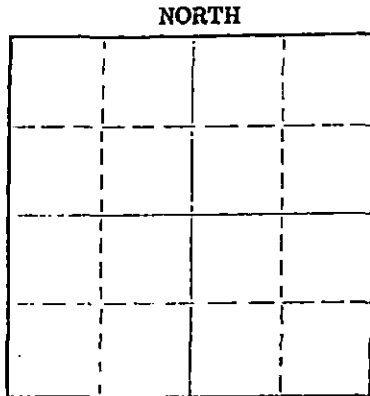

Locate well correctly on above Section Plot

Edwards County. Sec. 33 Twp. 24S Rgo. 18W (EX (W)
Location as "NE/CNW2SW" or footage from lines C SE NW
Lease Owner Voyager Petroleum, Kansas-Nebraska Nat Gas, Sterling
Lease Name Gatterman #1 Well No. 1 Drilling Company
Office Address P. O. Box 129, Sterling, Kansas 67579
Character of Well (completed as Oil, Gas or Dry Hole) Dry Hole
Date well completed July 17, 1975 19
Application for plugging filed July 16, 1975 19
Application for plugging approved July 16, 1975 19
Plugging commenced 12:30 AM, July 17, 1975 19
Plugging completed 2:45 AM, July 17, 1975 19
Reason for abandonment of well or producing formation Dry Hole

If a producing well is abandoned, date of last production 19
Was permission obtained from the Conservation Division or its agents before plugging was commenced? Yes

Name of Conservation Agent who supervised plugging of this well G. R. Biberstein
Producing formation _____ Depth to top _____ Bottom _____ Total Depth of Well 4693' F-1
Show depth and thickness of all water, oil and gas formations.

OIL, GAS OR WATER RECORDS

CASING RECORD

FORMATION	CONTENT	FROM	TO	SIZE	PUT IN	PULLED OUT
				8 5/8"	269.5'	None

Describe in detail the manner in which the well was plugged, indicating where the mud fluid was placed and the method or methods used in introducing it into the hole. If cement or other plugs were used, state the character of same and depth placed, from _____ feet to _____ feet for each plug set.

Filled hole with heavy mud.
Pumped 35 sacks at 250' thru open end of drillpipe; filled hole to 40', solid bridge with plug and hulls; pumped 15 sacks to surface, 2 sacks in rathole.

RECEIVED
STATE CORPORATION COMMISSION

JUL 21 1975

(If additional description is necessary, use BACK of this sheet)
Name of Plugging Contractor Sterling Drilling Company CONSERVATION DIVISION
Address P. O. Box 129, Sterling, Kansas 67579 Wichita, Kansas

STATE OF KANSAS COUNTY OF RICE, ss.
F. A. Wuellner (employee of owner) or (owner or operator) of the above-described well being first duly sworn on oath, says: That I have knowledge of the facts, statements, and matters herein contained and the log of the above-described well as filed and that the same are true and correct. So help me God. STERLING DRILLING COMPANY

(Signature) F. A. Wuellner
F. A. Wuellner, Secretary
P. O. Box 129, Sterling, Kansas 67579
(Address)

Subscribed and sworn to before me this 17th day of July, 19 75

CHARLES HALL—NOTARY PUBLIC
My Commission Expires Jan. 6, 1978

Charles M. Hall, Notary Public.



15-047-20178-0000

STERLING DRILLING COMPANY
P. O. Box 129
Sterling, Kansas 67579

WELL LOG ----- CATERMAN #1
Located: C SE NW, Section 33-245-18N, Edwards County,
Kansas

OWNER: Voyager Petroleum, Kansas-Nebraska Natural Gas, Sterling Drilling Co.
ROTARY DRILLING CONTRACTOR: Sterling Drilling Company

COMMENCED: July 2, 1975
COMPLETED: July 17, 1975

TOTAL DEPTH: 4693'

LOG

0 - 115	Sand and Clay
115 - 1253	Sand and Shale
1253 - 1272	Anhydrite
1272 - 2170	Shale and Shells
2170 - 2880	Lime and Shale
2880 - 3000	Lime
3000 - 3935	Lime and Shale
3935 - 3989	Shale
3989 - 4045	Lime
4045 - 4150	Lime and Shale
4150 - 4260	Lime
4260 - 4415	Lime and Shale
4415 - 4480	Lime
4480 - 4525	Lime and Shale
4525 - 4540	Lime, Shale, Chert
4540 - 4544	Lime and Shale
4544 - 4570	Chert and Lime
4570 - 4620	Lime
4620 - 4660	Lime, Chale, Sand and Chert
4660 - 4693	Sand, Lime and Chert

CASING RECORD

Ran 6 joints new 28# 8 5/8" casing.
258.57' set at 269.5' K.B. with 225 sacks
60/40 Pozmix with 3% cc. Plug down at
7:45 PM, 7-2-75 by Howco.

Plugged.

RECEIVED
STATE CORPORATION COMMISSION

JUL 21 1975

CONSERVATION DIVISION
Wichita, Kansas