


15-047-00021-0000

STATE OF KANSAS
STATE CORPORATION COMMISSION
Give All Information Completely
Make Required Affidavit
Mail or Deliver Report to:
Conservation Division
State Corporation Commission
211 No. Broadway
Wichita, Kansas

WELL PLUGGING RECORD

Edwards County. Sec. 31 Twp. 24S Rge. 18 ~~XX~~ (W)

Location as "NE/CNW/SW" or footage from lines SW SW NE
Lease Owner D.R. Lauck Oil Company, Inc.
Lease Name Jarvis Well No. 1
Office Address 301 So. Broadway Wichita 2 Kansas
Character of Well (completed as Oil, Gas or Dry Hole) dry hole
Date well completed April 13 19 59
Application for plugging filed " 19 59
Application for plugging approved " 19 59
Plugging commenced " 19 59
Plugging completed " 19 59
Reason for abandonment of well or producing formation dry hole

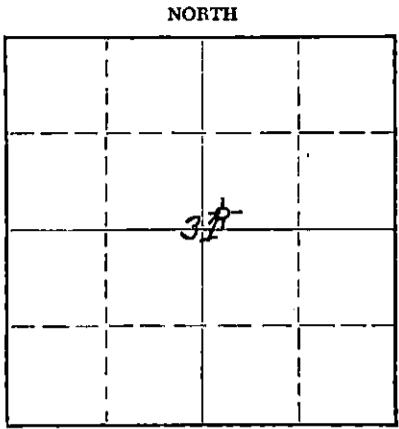

Locate well correctly on above Section Plat

If a producing well is abandoned, date of last production 19
Was permission obtained from the Conservation Division or its agents before plugging was commenced? yes

Name of Conservation Agent who supervised plugging of this well Frank Broadfoot
Producing formation Depth to top Bottom Total Depth of Well 4700 Feet
Show depth and thickness of all water, oil and gas formations.

OIL, GAS OR WATER RECORDS

CASING RECORD

FORMATION	CONTENT	FROM	TO	SIZE	PUT IN	PULLED OUT
		0	227	8 5/8"	227	none

Describe in detail the manner in which the well was plugged, indicating where the mud fluid was placed and the method or methods used in introducing it into the hole. If cement or other plugs were used, state the character of same and depth placed, from feet to feet for each plug set.

hole filled with mud 4700 - 220
plug 220 - 216
cement 216 - 40
mud 40 - 35
plug 35 - 31
cement 31 - 6' bottom of cellar

4-22-59
RECEIVED
STATE CORPORATION COMMISSION
APR 22 1959
CONSERVATION DIVISION
Wichita, Kansas

(If additional description is necessary, use BACK of this sheet)
Name of Plugging Contractor Sun Cementing Company
Address Great Bend Kansas

STATE OF Kansas COUNTY OF Sedgwick ss.
John H. Knightley (employee of owner) of the above-described well, being first duly sworn on oath, says: That I have knowledge of the facts, statements, and matters herein contained and the log of the above-described well as filed and that the same are true and correct. So help me God.

(Signature) John H. Knightley
Wichita Kansas (Address)

ELIZABETH RAY
NOTARY PUBLIC
My commission expires Sept. 14, 1959

SUBSCRIBED AND SWORN TO before me this 20 day of April 19 59
Elizabeth Ray Notary Public.

PLUGGING
FILE SEC. 31 T. 24 R. 18 W
BOOK PAGE 23 LINE 13

15-047-00021-0008

D.R. Lauck Oil Company, Inc.

SW, SW NE Sec. 31-24S-18W
Edwards County, Kansas

Jarvis No. 1

Commenced: March 28, 1959
Completed: April 13, 1959

Casing Record: 227' 8 5/8" cemented w/200 sacks
Calcium Chloride 4 sacks

Elevation: GR 2189; DF 2191; KB 2193

Drillers Log

Sand & clay	90
clay	227
shale	520
red bed & sand	665
sand	705
red bed	965
red bed & shale	1290
Anhydrite	1310
shale & shells	1315
shale, shells & Red Bed	1640
shale & shells	1950
shale & lime	2025
lime & shale	2285
lime	2360
lime & shale	2850
shale & lime	2975
lime & shale	3105
shale & lime	3635
Lime	3950
Douglas	3980
shale & lime	4000
Lime	4055
Lime & chert	4089
Lime	4145
Lime, chert & shale	4175
Lime	4530
Lime & shale	4561
shale & lime	4563
sand & shale	4567
chert	4615
chert & shale	4655
chert	4700 R.T.D.

Tops

	<u>Sample</u>	<u>Welex</u>
Heebner	3892-1699	3891-1698
Toronto	3904-1711	3906-1713
Douglas	3919-1726	3924-1731
Brown Lime	4008-1815	4004-1811
Lansing-Kansas City	4018-1825	4016-1823
Base Kansas City	4338-2145	4336-2143
Mississippian	4563-2370	4566-2373
Kinderhook	4614-2421	4612-2419
Viola	4674-2481	4662-2469
Rotary Total Depth	4700-2507	4698-2505
DST #1 (S) 4539-2581 open 1 hr, good blow 1 hr; recov. 1620' salt water; ISIP 1550# in 20" IFP 210# FFP 845#, FSIP 1500#, in 30 min.		
DST #2 (S) 4610-4633 open 1 hr; weak blow 1 hr recov. 100' thin watery mud; ISIP 1585# in 20 min. IFP 0#; FFP 115#; FSIP 1450# in 30 min.		

D & A

2199
12/14/59
3/2/59

RECEIVED
STATE CORPORATION COMMISSION

APR 22 1959

CONSERVATION DIVISION
Wichita, Kansas

PLUGGING
FILE SEC. 31 T. 24 R. 18W
BOOK PAGE 33 LINE 13