


STATE OF KANSAS  
STATE CORPORATION COMMISSION  
Give All Information Completely  
Make Required Affidavit  
Mail or Deliver Report to:  
Conservation Division  
State Corporation Commission  
800 Bittling Building  
Wichita, Kansas

WELL PLUGGING RECORD

Edwards County. Sec. 26 Twp. 24 Rge. 18 (E) 18 (W)

Location as "NE/CNW%SW%" or footage from lines NE NE NW  
Lease Owner Natural Gas & Oil Corp and Oklahoma Exploration  
Lease Name White Well No. 1  
Office Address 1009 Central Building, Wichita 2, Kansas  
Character of Well (completed as Oil, Gas or Dry Hole) dry hole  
Date well completed August 23, 1953 19  
Application for plugging filed August 23, 1953 (orally) 19  
Application for plugging approved August 25, 1953 (written) 19  
Plugging commenced August 23, 1953 19  
Plugging completed August 23, 1953 19  
Reason for abandonment of well or producing formation \_\_\_\_\_

NORTH

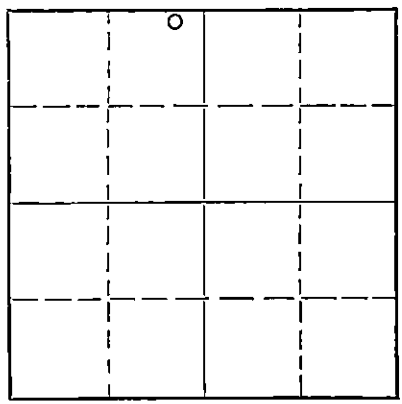

Locate well correctly on above Section Plat

If a producing well is abandoned, date of last production \_\_\_\_\_ 19  
Was permission obtained from the Conservation Division or its agents before plugging was commenced? yes

Name of Conservation Agent who supervised plugging of this well C. D. Stough, Box 207, Great Bend, Kansas  
Producing formation \_\_\_\_\_ Depth to top \_\_\_\_\_ Bottom \_\_\_\_\_ Total Depth of Well \_\_\_\_\_ Feet  
Show depth and thickness of all water, oil and gas formations.

OIL, GAS OR WATER RECORDS

CASING RECORD

FORMATION	CONTENT	FROM	TO	SIZE	PUT IN	PULLED OUT
surface		0	275	8 5/8"	275	none

Describe in detail the manner in which the well was plugged, indicating where the mud fluid was placed and the method or methods used in introducing it into the hole. If cement or other plugs were used, state the character of same and depth placed, from \_\_\_\_\_ feet to \_\_\_\_\_ feet for each plug set.

Filled hole with heavy mud from 4886 to 270 feet  
Set plug and ran 20 sacks cement from 270 to 220 feet  
Filled with heavy mud from 220 to 40 feet  
Set plug and ran 10 sacks cement from 40 feet to cellar.

8-27-53

(If additional description is necessary, use BACK of this sheet)

Name of Plugging Contractor Drilling Department of Natural Gas and Oil Corporation  
Address 1009 Central Building, Wichita 2, Kansas

STATE OF Kansas, COUNTY OF Sedgwick, ss.  
Harold A. Burt (employee of owner) or (OWNER REPRESENTATIVE) of the above-described well, being first duly sworn on oath, says: That I have knowledge of the facts, statements, and matters herein contained and the log of the above-described well as filed and that the same are true and correct. So help me God.

(Signature) Harold A. Burt  
1009 Central Building, Wichita, Ks  
(Address)

SUBSCRIBED AND SWORN TO before me this 26th day of August, 19 53

Esther C. Small  
Notary Public.

My commission expires May 25, 1957.

**PLUGGING**  
FILE SEC 26-24-R18W  
BOOK PAGE 124 LINE 21

## DRILLERS LOG

COMPANY: Natural Gas and Oil Corporation and  
Oklahoma Exploration

LOCATION: White #1 NE NE NW 26-24-18W  
Edwards County, Kansas

CONTRACTOR: Drilling Department-Natural Gas & Oil Corp.

COMMENCED: Rotary July 31, 1953

COMPLETED: Rotary August 23, 1953

ELEVATION: 2149

0 to 30 Surface clay & Sand  
30 to 130 Sand  
130 to 165 Clay w/sand streaks  
165 to 475 Shale and shells  
475 to 1195 Redbed, shells, sand  
1195 to 1215 Anhydrite  
1215 to 1340 Redbed and shells  
1340 to 1520 Shale & shells  
1520 to 1760 Shale & lime  
1760 to 1830 Shale & shells w/salt  
1830 to 1885 Shale & shells  
1885 to 1950 Lime & shale  
1950 to 3694 Lime & shale  
3694 to 3780 Shale  
3780 to 3962 Lime & shale  
3962 to 4475 Lime  
4475 to 4510 Chert & Lime  
4510 to 4546 Lime, chert & shale  
4546 to 4547 Chert  
4547 to 4563 Sand  
4563 to 4633 Lime & shale  
4633 to 4696 Chert, Lime & shale  
4696 to 4713 Cherty Lime  
4713 to 4804 Lime & chert  
4804 to 4830 Lime & shale  
4830 to 4886 Lime, sand & shale  
4886 T.D. (RB)

Set 275' of 8 5/8" 24# surface pipe. Cemented with 275 sacks cement and 5 sacks cal. chloride.


TOPS: Anhydrite	1195	Lansing	3951	Misner Sd	4536
Heebner	3817	Miss Chert	4468	Viola	4599
Brown Lime	3936	Kinderhook Shale	4532	Simpson	4799
				EL. Arbuckle	4881
				ST Arbuckle	4875

## DRILL STEM TESTS:

- #1 4182-4208, op 1 hr. rec 180' Gas, 55' SL O&GCM, BHP 480#
- #2 4451-78, gas to surf in 55 min, open 1 hr, rec 45' mud, BHP 960#.
- #3 4470-96, op 1 hr, strong blow for 1 hr, rec 3000' gas, 120' GCM, closed in 30 min, IFP 40#, FFP 90#, BHP 1005#.
- #4 4527-47, wk blow 7 min, rec. 13' mud specked with oil in tool, EST BHP 650#.
- #5 4876-86, wk blow 2 hr, rec 183' muddy sul. wtr. BHP 1450#.

Schlumberger Ran  
Dry, Plugged and Abandoned

8-2-53

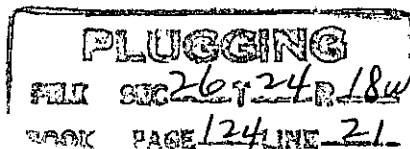

PAGE #2

DRILLERS LOG

COMPANY:

Natural Gas and Oil Corporation and  
Oklahoma Exploration

LOCATION:

White #1 NE NE NW 26-24-18W  
Edwards County, Kansas

C E R T I F I C A T E

I, Harold A. Burt, do hereby certify that the above and fore-  
going is a true and correct copy of the log of the White #1  
NE NE NW 26-24-18W, Edwards County, Kansas as reflected by  
files of the Natural gas and Oil Corporation.

Harold A. Burt  
Harold A. Burt

Subscribed and sworn to before me, a Notary Public, within and  
for Sedgwick County, Kansas, this 25th day of August, 1953.

My Commission expires May 25, 1957.

Esther Unsell  
Esther Unsell, notary public