


STATE OF KANSAS  
STATE CORPORATION COMMISSION

## WELL PLUGGING RECORD

Give All Information Completely  
Make Required Affidavit  
Mail or Deliver Report to  
Conservation Division  
State Corporation Comm.  
245 North Water  
Wichita, KS 67202

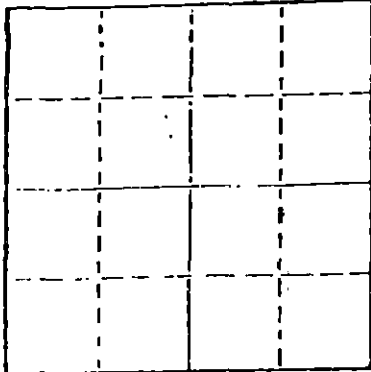

Locate well correctly on above  
Section Plat

Hodgeman County. Sec. 8 Twp. 24S Rge. 21 E/W  
Location as "NE/CNW $\frac{1}{4}$ SW $\frac{1}{4}$ " or footage from lines

C SW NW  
Lease Owner Antares Oil Corporation  
Lease Name Hogan Well No. 1  
Office Address 1546 Cole Blvd, Suite 200, Golden, CO 80401  
Character of Well (Completed as Oil, Gas or Dry Hole)

Dry Hole  
Date Well completed 12-3 1980  
Application for plugging filed 12-3 1980  
Application for plugging approved 12-3 1980  
Plugging commenced 12-3 1980  
Plugging completed 12-3 1980  
Reason for abandonment of well or producing formation

If a producing well is abandoned, date of last production 19

Was permission obtained from the Conservation Division or its agents before plugging was commenced? yes

Name of Conservation Agent who supervised plugging of this well Clarence Thomsas, Jr.  
Producing formation Depth to top Bottom Total Depth of Well 4780'  
Show depth and thickness of all water, oil and gas formations.

## OIL, GAS OR WATER RECORDS

## CASING RECORD

FORMATION	CONTENT	FROM	TO	SIZE	PUT IN	PULLED OUT
				8 5/8"	325'	none

Describe in detail the manner in which the well was plugged, indicating where the mud fluid was placed and the method or methods used in introducing it into the hold. If cement or other plugs were used, state the character of same and depth placed, from feet to feet for each plug set.

900' 60 sx, cement  
330' 35 sx, cement  
40' 10 sx, cement  
5 sx in rathole

(If additional description is necessary, use BACK of this sheet)


Name of Plugging Contractor White & Ellis Drilling, Inc.  
401 E. Douglas, Suite 500, Wichita, KS 67202

STATE OF KANSAS COUNTY OF SEDGWICK, ss.  
Ernest Sifford (employee of owner) or (owner or operator)  
of the above-described well, being first duly sworn on oath, says: That I have knowledge of the facts, statements, and matters herein contained and the log of the above-described well as filed and that the same are true and correct. So help me God.

(Signature) Ernest Sifford  
401 E. Douglas - Suite 500, Wichita, Ks.  
(Address) 67202

SUBSCRIBED AND SWORN TO before me this 29th day of December, 19 80

My commission expires

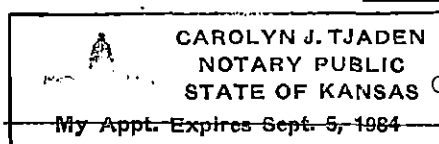

Carolyn J. Tjaden  
Carolyn J. Tjaden Notary Public.

STATE CORPORATION COMMISSION

DEC 30 1980 12-30-80

CONSERVATION DIVISION  
Wichita, Kansas

DRILLERS LOG

OPERATOR: Antares Oil Corporation, 1546 Cole Blvd., Suite 200, Golden, CO 80401  
CONTRACTOR: White & Ellis Drilling, Inc., Box 448, El Dorado, Kansas 67042

Lease Name Hogan Well No. 1

Sec. 8 T. 24S R. 21W Spot C SW NW

County Hodgeman State Kansas Elevation \_\_\_\_\_

Casing Record:

Surface: 8 5/8" @ 325' with 200 <sup>3% cc</sup> 2% gel Sxs.

Production: \_\_\_\_\_ @ \_\_\_\_\_ with \_\_\_\_\_ Sxs.

Type Well: D & A Total Depth 4780'

Drilling Commenced: 11-17-80 Drilling Completed 12-3-80

Formation	From	To	Tops
Cellar	0	5	Mississippi 4755
Shale, Sand	5	102	
Shale, Lime	102	196	
Shale	196	330	
Shale, Sand	330	755	
Shale	755	942	
Sand	942	1055	
Shale	1055	1283	
Shale, Sand	1283	1472	
Anhydrite	1472	1487	
Shale, Sand	1487	1740	
Shale	1740	2346	
Shale, Lime	2346	3040	
Lime	3040	3176	
Shale, Lime	3176	3315	
Lime	3315	3525	
Shale, Lime	3525	4432	
Lime	4432	4780	

COMPLETION RECORD

Liner Record: Size \_\_\_\_\_ From \_\_\_\_\_ To \_\_\_\_\_

Cementing Record: \_\_\_\_\_ Sacks \_\_\_\_\_

Perforating Record:

Formation	Perforated Interval	Number Shots
_____	_____	_____
_____	_____	_____
_____	_____	_____
_____	_____	_____

Initial Production: \_\_\_\_\_ DEC 30 1980

Electric Log \_\_\_\_\_ Type and Depths Covered \_\_\_\_\_  
CONSERVATION DIVISION  
Wichita, Kansas