

This form shall be filed in duplicate with the Kansas Corporation Commission, 200 Colorado Derby Building, Wichita, Kansas 67202, within ten days after the completion of the well, regardless of how the well was completed.

Attach separate letter of request if the information is to be held confidential. If confidential, only file one copy. Information on side one will be of public record and side two will then be held confidential.

Circle one: (Oil) Gas, Dry, SWD, OWWO, Injection. Type and complete ALL sections. Applications must be filed for dual completion, commingling, SWD and injection, T.A.

Attach wireline logs (i.e. electrical log, sonic log, gamma ray neutron log, etc.). KCC # (316) 263-3238. (Rules 82-2-105 & 82-2-125)

OPERATOR Pendleton Land and Exploration, Inc.

API NO. 15-083-20,911-0000

ADDRESS 23 Inverness Way East Englewood, CO 80112

COUNTY Hodgeman

FIELD wildcat SAW LOG CREEK, So.

\*\*CONTACT PERSON Lee Brian VanRamshorst PHONE 303/773-1776

PROD. FORMATION Mississippi

PURCHASER Permian Corporation

LEASE Virginia Gleason

ADDRESS P. O. Box 1183 Houston, TX 77001

WELL NO. 5 (five)

WELL LOCATION 2239' FWL & 1649' FSL

DRILLING Buffalo Drilling Rig #7

2239 Ft. from W Line and


CONTRACTOR

1649 Ft. from S Line of

ADDRESS 435 Page Court - 220 W. Douglas Wichita, KS 67202

the SW 1/4 SEC. 5 TWP. 24S RGE. 21W

WELL FLAT

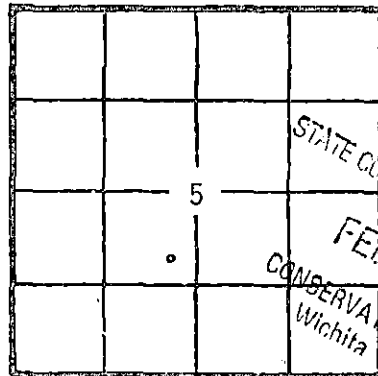

KCC  
KGS  
(Office Use)  
RECEIVED  
FEB 18 1982  
CONSERVATION DIVISION  
Wichita Kansas

PLUGGING - - - - -  
CONTRACTOR  
ADDRESS

TOTAL DEPTH 4645' PBTD open hole

SPUD DATE 10/17/81 DATE COMPLETED 12/09/81

ELEV: GR 2364' DF KB 2369'

DRILLED WITH (CABLE) (ROTARY) (AIR) TOOLS

Amount of surface pipe set and cemented 605' DV Tool Used? no

AFFIDAVIT

STATE OF Colorado, COUNTY OF Arapahoe SS, I,

Lee Brian VanRamshorst OF LAWFUL AGE, BEING FIRST DULY SWORN UPON HIS OATH, DEPOSES THAT HE IS Manager of Operations (FOR)(OF) Pendleton Land and Exploration, Inc. OPERATOR OF THE Virginia Gleason LEASE, AND IS DULY AUTHORIZED TO MAKE THIS AFFIDAVIT FOR AND ON THE BEHALF OF SAID OPERATOR, THAT WELL NO. 5 ON SAID LEASE HAS BEEN COMPLETED AS OF THE 9th DAY OF December, 19 81, AND THAT ALL INFORMATION ENTERED HEREIN WITH RESPECT TO SAID WELL IS TRUE AND CORRECT.

FURTHER AFFIANT SAITH NOT.

(S) *Lee Brian VanRamshorst*

SUBSCRIBED AND SWORN BEFORE ME THIS 9th DAY OF February, 19 82.

*Emily Ann Downs*

NOTARY PUBLIC

MY COMMISSION EXPIRES: September 21, 1985

Emily Ann Downs  
23 Inverness Way East, Englewood, CO 80112

\*\*The person who can be reached by phone regarding any questions concerning this information. Within 45 days of completion, a witnessed initial test by the Commission is required if the well produces more than 25 BOPD or is located in a Basic Order Pool.