


15-675-00062-0000
WELL PLUGGING RECORD

Give All Information Completely
Make Required Affidavit
Mail or Deliver Report to:
Conservation Division
State Corporation Commission
211 No. Broadway
Wichita, Kansas

NORTH

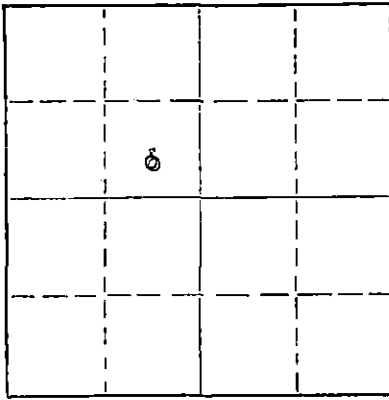

Locate well correctly on above
Section Plot

Hamilton County, Sec. 10 Twp. ^{24S} Rge. 41 (E) W (W)
Location as "NE/CNW/SW" or footage from lines c SE NW
Lease Owner Publishers Petroleum
Lease Name Raney Well No. 1
Office Address Oklahoma Publishing Co., Oklahoma City, Okla.
Character of Well (completed as Oil, Gas or Dry Hole) Dry Hole
Date well completed 10/25 1962
Application for plugging filed 11/28 1962
Application for plugging approved Verbal-H.E. Scott 11/29 1962
Plugging commenced 11/29 1962
Plugging completed 11/29 1962
Reason for abandonment of well or producing formation Formation would not produce gas.
If a producing well is abandoned, date of last production None 19
Was permission obtained from the Conservation Division or its agents before plugging was commenced? Yes

Name of Conservation Agent who supervised plugging of this well Hugh E. Scott
Producing formation Winfield Depth to top 2496 Bottom 2516 Total Depth of Well 2518 Feet
Show depth and thickness of all water, oil and gas formations.

OIL, GAS OR WATER RECORDS

CASING RECORD

FORMATION	CONTENT	FROM	TO	SIZE	PUT IN	PULLED OUT
Blue Shale				8 5/8"	134	None - Cement Circ.
Winfield				4 1/2"	2518	1003'

Describe in detail the manner in which the well was plugged, indicating where the mud fluid was placed and the method or methods used in introducing it into the hole. If cement or other plugs were used, state the character of same and depth placed, from _____ feet to _____ feet for each plug set.

Ran "free-point" indicator. Found casing free @ 1010' (KB). Set Baker Cast Iron Bridge Plug @ 2460 inside 4 1/2" casing. Filled casing with mud. Cut casing at 1010 KB. Pulled casing until bottom was at 145'. Filled hole with mud from 2460' to 145'. Circulated cement to place cement plug from 145' to surface. Welded cap over top of 8 5/8" casing and filled cellar.

RECEIVED
STATE CORPORATION COMMISSION

DEC 4 1962

CONSERVATION DIVISION
Wichita, Kansas

(If additional description is necessary, use BACK of this sheet)

Name of Plugging Contractor Patrick Well Service Co.
Address Liberal, Kansas

STATE OF Kansas, COUNTY OF Hamilton, ss.

Donald W. Jackson (employee of owner) or (owner or operator) of the above-described well, being first duly sworn on oath, says: That I have knowledge of the facts, statements, and matters herein contained and the log of the above-described well as filed and that the same are true and correct. So help me God.

(Signature)

Donald W. Jackson
1411 N. CARLTON LIBERAL, KAN
(Address)

SUBSCRIBED AND SWORN TO before me this 3rd day of December, 1962

My commission expires June 7, 1964

P.C. Frazee
Notary Public.

January 10, 1963

Drillers Logs C SE NW
Raney Unit #1 10-24-41W
Hamilton County, Kansas

0 - 1949'	Shale
1949' - 2094'	Shale & Anhydrite
2094' - 2402'	Shale
2402' - 2512'	Lime & Shale
2512' - 2540'	Shale

RECEIVED
STATE CORPORATION COMMISSION

JAN 15 1963

CONSERVATION DIVISION
Wichita, Kansas

Subscribed and sworn to before me

this 10 day of January 1963

Mary D. Cook
Notary Public

My Commission Expires:

January 29, 1965