


STATE OF KANSAS
STATE CORPORATION COMMISSION

Give All Information Completely
Make Required Affidavit
Mail or Deliver Report to:
Conservation Division
State Corporation Commission
211 No. Broadway
Wichita, Kansas

WELL PLUGGING RECORD

Finney County, Sec. 26 Twp. 24-S Rge. 31 (E) W (W)

Location as "NE/CNW/SW" or footage from lines C SE/4
Lease Owner Apache Corporation
Lease Name Westphal Unit Well No. 1
Office Address 823 South Detroit, Tulsa, Oklahoma 74120
Character of Well (completed as Oil, Gas or Dry Hole) Gas
Date well completed February 15 19 62
Application for plugging filed March 10 19 64
Application for plugging approved March 11 19 64
Plugging commenced March 23 19 64
Plugging completed March 24 19 64
Reason for abandonment of well or producing formation Marginal well with no market available.

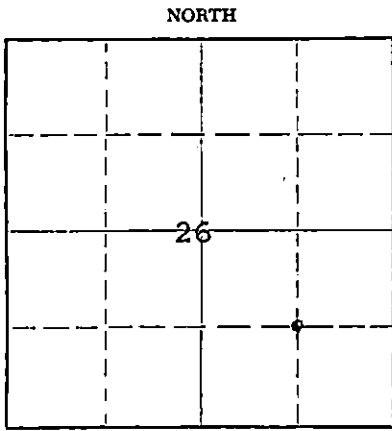

Locate well correctly on above Section Plat

If a producing well is abandoned, date of last production No production 19
Was permission obtained from the Conservation Division or its agents before plugging was commenced? Yes

Name of Conservation Agent who supervised plugging of this well Mr. Hugh Scott
Producing formation Krider Depth to top 2683 Bottom 2687 Total Depth of Well 2710 Feet
Show depth and thickness of all water, oil and gas formations.

OIL, GAS OR WATER RECORDS

CASING RECORD

FORMATION	CONTENT	FROM	TO	SIZE	PUT IN	PULLED OUT
Base Stone Coral		2008		8-5/8	347	None
Herrington	Water	2654		4-1/2	2708	2049
Krider	Gas	2683	2687			

Describe in detail the manner in which the well was plugged, indicating where the mud fluid was placed and the method or methods used in introducing it into the hole. If cement or other plugs were used, state the character of same and depth placed, from _____ feet to _____ feet for each plug set.

Pumped 10 sacks cement to 2178', followed with wire line and plug.
Filled hole and spotted 35 sacks cement across shoe of 8-5/8" OD 375 to 265'.
Spotted 15 sacks cement 45' to 0' in top of 8-5/8" OD.

RECEIVED
STATE CORPORATION COMMISSION
3-24-64
APR 24 1964

CONSERVATION DIVISION
Wichita, Kansas

(If additional description is necessary, use BACK of this sheet)

Name of Plugging Contractor Daco Lease and Well Service
Address 1700 South Main Street, Borger, Texas

STATE OF Oklahoma COUNTY OF Tulsa, ss.
Geo. J. McLernon, Jr. (employee of owner) or (owner or operator) of the above-described well, being first duly sworn on oath, says: That I have knowledge of the facts, statements, and matters herein contained and the log of the above-described well as filed and that the same are true and correct. So help me God.

(Signature) *[Signature]*
823 South Detroit, Tulsa, Oklahoma 74120
(Address)

SUBSCRIBED AND SWORN to before me this 23 day of April, 1964

My commission expires January 7, 1967

[Signature]
Notary Public.

APACHE OIL CORPORATION - Operator

SIERRA PETROLEUM CO., INC. - Contr.

WYSTEPHAL #1
 C SP
 Sec. 26-24S-31W
 Finney County, Kansas

T. D.: 2709'
 Elev.: 2872' D.F.

Commenced: 1-12-62
 Completed: 1-15-62

Casings:

8-5/8" Set at 337'
 4-1/2" Set at 2708'

Cement:

with 200 sq. cement
 with 100 sq. cement

FORMATION	DEPTH
Surface Soil & Clay	337
Blue Shale, Gyp & Gray Shale	625
Gray Shale & Gyp	1025
Red Bed & Sand	1250
Red Bed	1309
Anhydrite & Red Bed	1477
Sand	1705
Shale & Red Bed	1933
Anhydrite	1944
Shale & Shells	2050
Sandy Shale	2295
Shale & Lime	2710

RECEIVED
 STATE CORPORATION COMMISSION

MAR 11 1964 3-11-64

CONSERVATION DIVISION
 Wichita, Kansas

STATE OF KANSAS }
 COUNTY OF RUSSELL } ss:

I hereby certify that the above information is true and correct to the best of my knowledge.

C. T. Honaker

Subscribed and sworn to before me this 17th day of January, 1962.

LeRoy Gutz
 Notary Public

My commission expires: 10-17-63

