


WELL PLUGGING RECORD

Give All Information Completely  
Make Required Affidavit  
Mail or Deliver Report to:  
Conservation Division  
State Corporation Commission  
211 No. Broadway  
Wichita, Kansas

NORTH

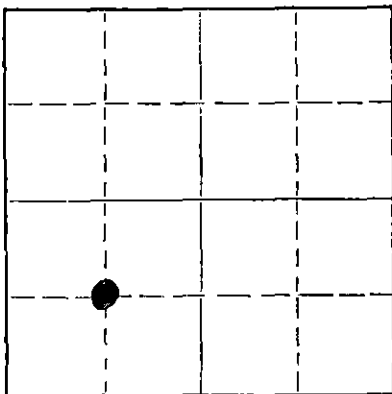

Locate well correctly on above  
Section Plat

Finney County. Sec. 3 Twp. 24S Rge. 31 ~~W~~ (W)  
Location as "NE/CNW/SW" or footage from lines C SW/4  
Lease Owner Apexco, Inc.  
Lease Name Sherman Byers Well No. 1  
Office Address 1121 First Place, Tulsa, OK 74103  
Character of Well (completed as Oil, Gas or Dry Hole) Gas  
Date well completed December 12 19 61  
Application for plugging filed January 16 19 76  
Application for plugging approved January 20 19 76  
Plugging commenced February 15 19 76  
Plugging completed \_\_\_\_\_ 19 \_\_\_\_\_  
Reason for abandonment of well or producing formation Uneconomical to produce

If a producing well is abandoned, date of last production June 30 19 75  
Was permission obtained from the Conservation Division or its agents before plugging was commenced? Yes

Name of Conservation Agent who supervised plugging of this well Clarence Thomas  
Producing formation Krider Depth to top 2692 Bottom 2704 Total Depth of Well 2705 Feet  
Show depth and thickness of all water, oil and gas formations.

OIL, GAS OR WATER RECORDS

CASING RECORD

FORMATION	CONTENT	FROM	TO	SIZE	PUT IN	PULLED OUT
Krider	Dolomite	2692	2704	8-5/8"	364	0
				4-1/2"	2704	1019'

Describe in detail the manner in which the well was plugged, indicating where the mud fluid was placed and the method or methods used in introducing it into the hole. If cement or other plugs were used, state the character of same and depth placed, from \_\_\_\_\_ feet to \_\_\_\_\_ feet for each plug set.

Pumped 10 sx. cement plug to 2513', top of cement at 2400', shot casing at 1216' and 1011' came free at 1011', cement plugs 950'-850' (35 sx.), 350'-250' (35 sx.), 40'-6' (15 sx.) Welede on cap and set dry hole marker. Fresh water between plugs.

RECEIVED  
STATE CORPORATION COMMISSION  
2-20-76  
FEB 20 1976  
CONSERVATION DIVISION  
Wichita, Kansas

(If additional description is necessary, use BACK of this sheet)  
Name of Plugging Contractor Lillard Casing Pullers  
Address Woodward, Oklahoma

STATE OF Oklahoma, COUNTY OF Tulsa, ss.  
R. L. Clemons (employee of owner) or (owner or operator) of the above-described well, being first duly sworn on oath, says: That I have knowledge of the facts, statements, and matters herein contained and the log of the above-described well as filed and that the same are true and correct. So help me God.

(Signature) R. L. Clemons  
1121 First Place, Tulsa, OK 74103  
(Address)

SUBSCRIBED AND SWORN TO before me this 13 day of February, 19 76  
David D. ...  
Notary Public.

My commission expires 7-10-78

15-055-00815-0000

COPY


WELL LOG BUREAU—KANSAS GEOLOGICAL SOCIETY  
508 East Murdock, Wichita, Kansas

Company- APACHE CORPORATION  
Farm-Sherman Byers Unit No. 1

SEC. 3 T. 24 R. 31W  
C SW

Total Depth. 2705'  
Comm. 11-26-61 Comp. 11-30-61  
Shot or Treated.  
Contractor. Sierra Petroleum Co.  
Issued. 3-31-62

County Finney  
KANSAS

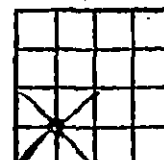

Elevation. 2892' RB

Production. 7,000,000 CFG

CASING:

8 5/8" 364' cem w/225 sx.  
4 1/2" 2704' cem w/100 sx.

Figures Indicate Bottom of Formations.

surface soil & clay	40
sand	280
shale	840
sand	1020
sandy shale & red bed	1390
shale, gypsum & red bed	1780
salt & red bed	2027
Anhydrite	2045
lime & shale	2060
red bed	2235
shale, shells & red bed	2445
shale & lime	2705
Total Depth	

TOPS: SCOUT

Base Stone Corral	2040
Herington	2644
Krider	2683

5-7-76