

STATE OF KANSAS
STATE CORPORATION COMMISSION

WELL PLUGGING RECORD

Give All Information Completely
Make Required Affidavit
Mail or Deliver Report to
Conservation Division
State Corporation Comm.
245 North Water
Wichita, KS 67202

Kiowa County, Sec. 36 Twp. 27S Rge. 16W E/W
Location as "NE/CNW 1/4 SW 1/4" or footage from lines
700 FSL 1980 FWL


Lease Owner Texas Oil & Gas Corporation
Lease Name Young Well No. J-1
Office Address Suite 300-200 W. Douglas, Wichita, Ks. 67202
Character of Well (Completed as Oil, Gas or Dry Hole)
Gas

Date Well completed April 9 19 80
Application for plugging filed 2-22 19 82
Application for plugging approved 2-24 19 82
Plugging commenced 3-17 19 82
Plugging completed 12:30 3-23 19 82
Reason for abandonment of well or producing formation
Not Productive

If a producing well is abandoned, date of last production
19

Was permission obtained from the Conservation Division or
its agents before plugging was commenced? Yes

Name of Conservation Agent who supervised plugging of this well Paul Luthi
Producing formation _____ Depth to top _____ Bottom _____ Total Depth of Well 4750
Show depth and thickness of all water, oil and gas formations.

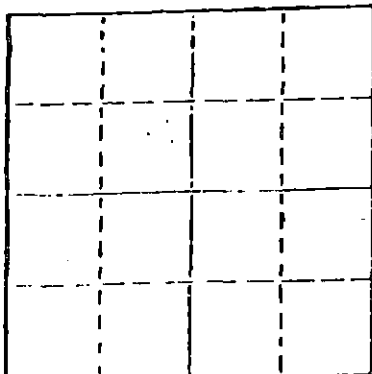

Locate well correctly on above
Section Plot

OIL, GAS OR WATER RECORDS

CASING RECORD

FORMATION	CONTENT	FROM	TO	SIZE	PUT IN	PULLED OUT
				8 5/8	409	None
				4 1/2	4749	2703

Describe in detail the manner in which the well was plugged, indicating where the mud fluid
was placed and the method or methods used in introducing it into the hold. If cement or other
plugs were used, state the character of same and depth placed, from _____ feet to
_____ feet for each plug set.

Plug back at 4610'
Sand from 4610' to 4550'
Dumped 4 sacks cement with dump bailer 4550' to 4510'
Ripped at 2703

Allied pump in 15 jell - 6 Hull 10 Gel
150 common 3% c.c.

(If additional description is necessary, use BACK of this sheet)

Name of Plugging Contractor Clarke Corporation

STATE OF Kansas COUNTY OF Barker, ss.
Elmer C. Margenstern (employee of ~~owner~~) or (~~owner~~ or operator)
of the above-described well, being first duly sworn on oath, says: That I have knowledge of
the facts, statements, and matters herein contained and the log of the above-described well
as filed and that the same are true and correct. So help me God.

(Signature) Elmer C. Margenstern
Medicine Lodge, Kansas
(Address)

SUBSCRIBED AND SWORN TO before me this 24th day of March, 1982

Jessie Hamilton
Notary Public.

My commission expires April 4, 1986

RECEIVED
STATE CORPORATION COMMISSION
MAR 25 1982
3-25-82
CONSERVATION DIVISION
Wichita Kansas

RECEIVED
PRODUCTION
APR 10 1980

No. 15-097-20,617-0000

KANSAS DRILLERS LOG

COMPANY Texas Oil & Gas Corp.

SEC. 36 T. 27 R. 16W
LOC. 700' FSL & 1980' FWL

FARM Young "J" NO. 1

COUNTY Kiowa

ROTARY TOTAL DEPTH 4,750'
COMM. March 22, 1980 COMP. March 31, 1980
CONTRACTOR H-30, INC. (Rig #5)
ISSUED April 9, 1980

CASING

10 3/4"
8 5/8" Set at 409' cemented w/400 sxs cement
5 1/2"
4 1/2" Set at 4,749' cemented w/150 sxs cement

ELEVATION 2,099' K.B.

FIGURES INDICATE BOTTOM OF FORMATIONS

Sand and Red Bed	426'
Red Bed and Shale	1,150'
Shale and Lime	2,135'
Lime and Shale	2,342'
Shale and Lime	2,552'
Lime and Shale	2,970'
Shale and Lime	3,208'
Lime and Shale	3,420'
Shale and Lime	3,861'
Lime and Shale	4,204'
Shale and Lime	4,348'
Lime and Shale	4,568'
Shale and Lime	4,630'
Lime and Shale	4,750'
Rotary Total Depth	4,750'

I hereby certify the above and foregoing to be a true and correct log of the above described well as shown by the drilling reports.

H-30, INC.

Dean Britting 2-24-82
Dean Britting

RECEIVED
STATE CORPORATION COMMISSION

FEB 24 1980

CONSERVATION DIVISION
Wichita Kansas

State of Kansas)
) ss:
County of Sedgwick)

Subscribed and Sworn to before me a Notary Public
in and for said county and state this 9th day of
April, 1980.

Elsie Willison - Notary Public

My Commission Expires:
July 25, 1982