


WELL PLUGGING RECORD

Give All Information Completely
Make Required Affidavit
Mail or Deliver Report to:
Conservation Division
State Corporation Commission
211 No. Broadway
Wichita, Kansas

T 26S NORTH R 33W

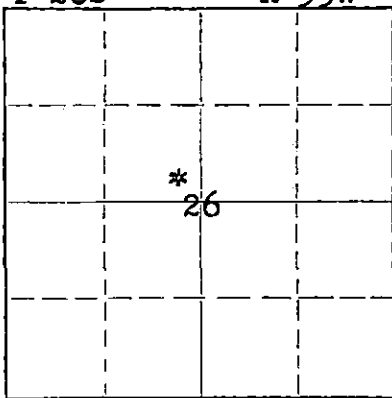

Locate well correctly on above Section Plat

Finney County, Sec. 26 Twp. 26S Rge. 33W (E) (W)
Location as "NE/CNW/SW" or footage from lines SE SE NW
Lease Owner Irving Greenspan
Lease Name Beyer Well No. 1
Office Address Dallas, Texas
Character of Well (completed as Oil, Gas or Dry Hole) _____
Date well completed _____ 19____
Application for plugging filed October 5 19 56
Application for plugging approved October 8 19 56
Plugging commenced October 7 19 56
Plugging completed October 15 19 56
Reason for abandonment of well or producing formation _____

If a producing well is abandoned, date of last production _____ 19____
Was permission obtained from the Conservation Division or its agents before plugging was commenced? Yes

Name of Conservation Agent who supervised plugging of this well Merle Rives
Producing formation _____ Depth to top _____ Bottom _____ Total Depth of Well 5275 Feet
Show depth and thickness of all water, oil and gas formations.

OIL, GAS OR WATER RECORDS

CASING RECORD

FORMATION	CONTENT	FROM	TO	SIZE	PUT IN	PULLED OUT
				13-3/8"	820'	None
				8-5/8"	2800'	1257'
				5-1/2"	4730'	3624'
				Plugged back to		4442'.

Describe in detail the manner in which the well was plugged, indicating where the mud fluid was placed and the method or methods used in introducing it into the hole. If cement or other plugs were used, state the character of same and depth placed, from _____ feet to _____ feet for each plug set.

Filled the hole with sand from 4442' to 4385' and ran 5 sacks of cement. Mudded the hole to 2780', set a rock bridge to 2770' and ran 20 sacks of cement. Mudded the hole to 500', set a 10' rock bridge and ran 30 sacks of cement. Mudded the hole to 20', set a rock bridge and ran 15 sacks of cement on top. Plugging Completed.

(If additional description is necessary, use BACK of this sheet)

Name of Plugging Contractor West Supply Co., Inc.
Address Chase, Kansas

STATE OF Kansas, COUNTY OF Rice, ss.
Noel J. Knight (employee of owner) or (~~owner or operator~~) of the above-described well, being first duly sworn on oath, says: That I have knowledge of the facts, statements, and matters herein contained and the log of the above-described well as filed and that the same are true and correct. So help me God.

(Signature) Noel J. Knight
Chase, Kansas 10-20-56
(Address)

SUBSCRIBED AND SWORN TO before me this 19th day of October, 1956
Edward E. Bruen

My commission expires May 20, 1956

PLUGGING
FILE SEC. 26 T. 26 R. 33W
BOOK PAGE 105 LINE 15

RECEIVED
STATE CORPORATION COMMISSION
OCT 20 1956
CONSERVATION DIVISION
Wichita, Kansas

10-20-1956

15-055-00124-0000

DRILLERS LOG

W. J. Coppinger et al

BEYER #1
SE SE NW 24-26S-33W
Finney County, Kansas

Casing Records:
13 3/8" at 820' w/600 ex.
8 5/8" at 2800' w/150 ex.
5 1/2" at 4730' w/180 ex.

Dirt	25
Sand	40
Clay	70
Sand & Clay	150
Sand & Gravel	380
Brown Clay	455
Clay & Sand	620
Clay & Shale	680
Clay	770
Sand	790
Clay & Blue Shale	820
Shale & Shells	890
Red Bed	1260
Red Bed & Shells	1295
Lime	1350
Red Bed, Lime, Shells, Shale	1390
Red Bed & Shale	1853
Red Bed & Lime	1880
Anhydrite	1975
Red Bed, Shells & Shale	2020
Red Bed, Lime & Shale	2065
Lime & Shale	2100
Lime, Shells & Shale	2150
Lime & Shale	2215
Lime	2250
Shale & Lime	2425
Lime	2542
Lime & Shale	2639
Lime	2758
Lime & Shale	2855
Sandy Lime	3100
Lime	3115
Shale	3130
Lime & Shale	3155
Sandy Lime & Shale	3230
Lime & Shale	3290
Broken Lime	3370
Lime & Shale	3617
Lime	3785
Lime & Shale	3935
Lime	3980
Shale & Lime	4055
Cherty Lime	4106
Lime	4180
Lime & Shale	4225
Lime	4514
Lime & Shale	4600
Lime	4636
Lime & Shale	4690
Lime	4772
Shale & Lime	4882

Tops:	
Stone Corral	1865
Herington	2595
Upper Krider	2613
Lower Krider	2636
Winfield	2668-72; 2679-93
Towanda	2726
Ft. Riley	2786
Pennsylvanian?	3430
Topeka	3530
Heebner	3981
Toronto	3995
Lansing	4024
Marmaton	4279
Cherokee	4732
Atoka	4928
Morrow Shale	4952
Unconformity Zone	5032
Mississippian	5074
St. Louis	5120
Total Depth	5275 in St. Louis

Comms: 7-18-52
Comp: 8-25-52
Elevation: 2922' D.F.

6-29-56

Lime	4960
Shale	5048
Lime & Sand	5070
Lime & Shale	5111
Lime	5152
Lime & Shale	5183
Lime	5192
Sandy Lime & Shale	5227
Lime & Shale	5258
Lime	5275
Total Depth	5275

STATE OF KANSAS:

I, the undersigned, being duly sworn on oath state the above statement and log is a true and correct record and log of the well drilled at the location above described.

Subscribed and sworn to before me this 4th day of September, 1952.

A. J. Carter
A. J. Carter

Henry S. Jackson
Notary Public

My commission expires:

PLUGGING
FILE SEC 24 T. 26 R. 33W
BOOK PAGE 75 LINE 23

copy sent Corp Comm. 9-12-52