


WELL PLUGGING RECORD

15-055-10127-0000

Give All Information Completely
Make Required Affidavit
Mail or Deliver Report to:
Conservation Division
State Corporation Commission
211 No. Broadway
Wichita, Kansas

Finney County, Sec. 17 Twp. 26S Rge. (E) 33 (W)

Location as "NE/CNW/SW" or footage from lines C NW NE
Lease Owner Mobil Oil Corporation
Lease Name Stone "A" Well No. 2
Office Address Box 1934, Oklahoma City, Oklahoma
Character of Well (completed as Oil, Gas or Dry Hole) Oil
Date well completed January 1, 1960
Application for plugging filed July 2, 1968
Application for plugging approved (Verbal) June 21, 1968
Plugging commenced June 21, 1968
Plugging completed June 25, 1968
Reason for abandonment of well or producing formation Production completed

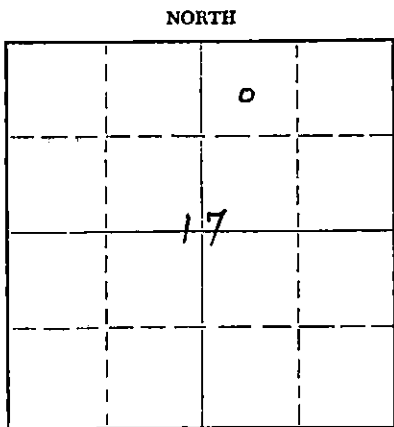

Locate well correctly on above Section Plat

If a producing well is abandoned, date of last production May 31, 1968
Was permission obtained from the Conservation Division or its agents before plugging was commenced? Yes

Name of Conservation Agent who supervised plugging of this well Edgar J. Eves, Sublette, Kansas
Producing formation Morrow Depth to top 5020 Bottom 5068 Total Depth of Well 5290 Feet
Show depth and thickness of all water, oil and gas formations.

OIL, GAS OR WATER RECORDS

CASING RECORD

FORMATION	CONTENT	FROM	TO	SIZE	PUT IN	PULLED OUT
Surface	Dry	0	1915	8-5/8	63	None
Morrow (Prod.)	Depleted	4930	5205	5-1/2	165	2170'

Describe in detail the manner in which the well was plugged, indicating where the mud fluid was placed and the method or methods used in introducing it into the hole. If cement or other plugs were used, state the character of same and depth placed, from _____ feet to _____ feet for each plug set.

Moved in and RUPU. COH w/rds in singles & pump. SION. COH w/165 jts 2-3/8 in EUE 8 RT 4.7 lb tbg. Pumped 1 sk ctn sd hulls & 1 bbl wtr followed by 25 sx comm cement w/1/2 sk hulls in 1st 5 sks. Displaced to 4000 ft with normal pressure. Psi rose gradually to 1000 psi w/top of cement @ 4500 ft. & stabilized @ 1000 psi. Displaced top of plug to 4806 ft. SIM mstrmnt. Stopped pumps. Psi firm. Rlsd presur; no flowback. Cement top by record, 2350 ft. Dialog shot off csg @ 2182 ft. COH w/69 jts, 2170 ft, 5 1/2 in 15.5 lb 8 RT J-55 R2 csg, Youngstown, in exclnt condition. SION. WIH w/2-3/8 in tbg to 1911 ft. Howco plug up from 1910 ft w/50 sx comm cement; COH. Rlsd unit. Welded temporary cap on top of 8-5/8 in csg. head.

RECEIVED
STATE CORPORATION COMMISSION
JUL 8 1968
CONSERVATION DIVISION
Wichita, Kansas

(If additional description is necessary, use BACK of this sheet)
Name of Plugging Contractor J. D. (Dubbs) Well Service
Address Box 246, Liberal, Kansas

STATE OF Oklahoma, COUNTY OF Oklahoma, ss.
W. J. Merka (employee of owner) or (owner or operator) of the above-described

well, being first duly sworn on oath, says: That I have knowledge of the facts, statements, and matters herein contained and the log of the above-described well as filed and that the same are true and correct. So help me God.

(Signature) W. J. Merka
Box 1934, Oklahoma City, Oklahoma
(Address)

SUBSCRIBED AND SWORN TO before me this 2nd day of July, 19 68

Murline Gardner
Notary Public.

My commission expires 9-8-71

WICHITA, KANSAS

DRILLER'S WELL LOG

#2 STONE A
 C NW NE SECTION 17-26S-33W
 FINNEY COUNTY, KANSAS

COMMENCED: SEPTEMBER 15, 1959
 COMPLETED: OCTOBER 12, 1959

OPERATOR: NORTHERN NATURAL GAS PRODUCING CO.

DEPTH		FORMATION	REMARKS
FROM	TO		
0	300	SAND	
300	615	SHALE & SHELLS	
615	900	SHALE & ANHYDRITE	
900	1100	RED BED	
1100	1318	GYP & SHALE	
1318	1850	RED BED	
1850	1915	SHALE & LIME	RAN 1915' OF 8-5/8" CASING CEMENTED @ 1915' W/950 SACKS CEMENT.
1915	2160	SHALE	
2160	2470	SHALE & SHELLS	
2470	3211	LIME & SHALE	
3211	3236	LIME	
3236	3797	LIME & SHALE	
3797	3918	CHALKY LIME	
3918	4428	LIME & SHALE	
4428	4513	LIME	
4513	4552	LIME & SHALE	
4552	5290	LIME	
5290	TD		RAN 165 JOINTS 5-1/2" CASING, CEMENTED @ 5205' W/ 275 SACKS CEMENT FIRST STAGE AND SECOND STATE 125 SACKS CEMENT.

I, E. E. HALL CERTIFY THIS IS A TRUE AND CORRECT COPY OF THE DRILLER'S WELL LOG FOR THE #2 STONE A.

E. E. Hall
 E. E. HALL

STATE OF KANSAS)
) SS
 COUNTY OF SEDGWICK)

BEFORE ME, THE UNDERSIGNED, A NOTARY PUBLIC WITHIN AND FOR SAID COUNTY AND STATE, ON THIS 16TH DAY OF OCTOBER, 1959, PERSONALLY APPEARED E. E. HALL TO ME PERSONALLY KNOWN TO BE THE IDENTICAL PERSON WHO EXECUTED THE WITHIN AND FOREGOING INSTRUMENT AND ACKNOWLEDGED TO ME THAT HE EXECUTED THE SAME AS HIS FREE AND VOLUNTARY ACT AND DEED FOR THE USES AND PURPOSES THEREIN SET FORTH.

IN WITNESS WHEREOF, I HAVE HEREUNTO SET MY HAND AND OFFICIAL SEAL THE DAY AND YEAR LAST ABOVE WRITTEN.

Vera M. McKenzie
 VERA M. MCKENZIE, NOTARY PUBLIC

MY COMMISSION EXPIRES OCTOBER 2, 1963.

Recd 7-15-68