


Give All Information Completely  
Make Required Affidavit  
Mail or Deliver Report to:  
Conservation Division  
State Corporation Commission  
211 No. Broadway  
Wichita, Kansas

WELL PLUGGING RECORD

Kearney County, Sec. 31 Twp. 24S Rge. 36 (W)

NORTH

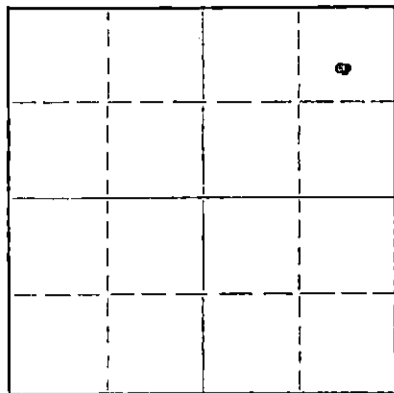

Locate well correctly on above Section Plat

Location as "NE/CNW/SW" or footage from lines C NE NE  
Lease Owner Cities Service Oil Company  
Lease Name Moser "A" Well No. 1  
Office Address Box 6 Liberal, Kansas  
Character of Well (completed as Oil, Gas or Dry Hole) Dry Hole  
Date well completed May 4, 19 63  
Application for plugging filed May 6, 19 63  
Application for plugging approved 19  
Plugging commenced May 4, 19 63  
Plugging completed May 4, 19 63  
Reason for abandonment of well or producing formation Dry Hole

If a producing well is abandoned, date of last production 19  
Was permission obtained from the Conservation Division or its agents before plugging was commenced? Yes

Name of Conservation Agent who supervised plugging of this well Mr. Hugh Scott  
Producing formation None Depth to top Bottom Total Depth of Well 5087' Feet  
Show depth and thickness of all water, oil and gas formations.

OIL, GAS OR WATER RECORDS

CASING RECORD

FORMATION	CONTENT	FROM	TO	SIZE	PUT IN	PULLED OUT
St. Louis	Nothing	5020	5030	8 5/8	1883	None
Morrow	Saltwater	4737	4750			
Marmaton	Nothing	4291	4303			
Lansing	Saltwater	3735	3756			
Lansing	Wtry mud	3685	3725			
Council Grove	Nothing	2830	2875			
Hugoton Series	Gas	2414	2620			

Describe in detail the manner in which the well was plugged, indicating where the mud fluid was placed and the method or methods used in introducing it into the hole. If cement or other plugs were used, state the character of same and depth placed, from \_\_\_\_\_ feet to \_\_\_\_\_ feet for each plug set.

Spotted heavy mud through drill pipe		5087'	4760'			
Spotted 20 sx cement	" "	4760'	4695'			
Spotted heavy mud	" "	4695'	4270'			
Spotted 15 sx cement	" "	4270'	4222'			
Spotted heavy mud	" "	4222'	3710'			
Spotted 15 sx cement	" "	3710'	3662'			
Spotted heavy mud	" "	3662'	2640'			
Spotted 20 sx cement	" "	2640'	2575'			
Spotted heavy mud	" "	2575'	1880'			
Spotted 20 sx cement	" "	1880'	1819'			
Spotted heavy mud	" "	1819'	35'			
Spotted 10 sx cement	" "	35'	to surface			

RECEIVED  
STATE CORPORATION COMMISSION  
MAY 13 1963  
CONSERVATION DIVISION  
WICHITA, KANSAS

(If additional description is necessary, use BACK of this sheet)

Name of Plugging Contractor Sun Oil Well Cementing Co.  
Address Hays, Kansas

STATE OF KANSAS, COUNTY OF SEWARD, ss.  
W. J. Devaney (employee of owner) or (~~owner~~) of the above-described well, being first duly sworn on oath, says: That I have knowledge of the facts, statements, and matters herein contained and the log of the above-described well as filed and that the same are true and correct. So help me God.

(Signature) W. J. Devaney  
Box 6 Liberal, Kansas  
(Address)

SUBSCRIBED AND SWORN TO before me this 7th day of May, 19 63  
Calvin Lindsey  
Calvin Lindsey Notary Public.

My commission expires 11-5-66



15-093-00053-0000

ROTARY DRILLING LOG

OWNER: Cities Service Oil Company      CASING: Set 8 5/8" O.D. 24# casing  
 CONTRACTOR: Prime Drilling Company      @ 1883', cemented with  
 LEASE: Moser "A" #1      1200 sx common cement  
 LOCATION: C NE NE Sec. 31-24S-36W  
 Kearny County, Kansas

0 - 250	Sand & Clay
250 - 305	Shale
305 - 625	Shale & Shells
625 - 750	Red Bed & Sand
750 - 1110	Shale & Shells
1110 - 1350	Anhydrite & Shale
1350 - 1628	Lime
1628 - 1870	Lime & Anhydrite
1870 - 1887	Lime
1887 - 1900	Anhydrite
1900 - 2422	Lime
2422 - 2857	Lime & Shale
2857 - 3005	Lime
3005 - 3060	Lime & Shale
3060 - 3270	Lime
3270 - 3445	Lime & Chalk
3445 - 3680	Lime & Shale
3680 - 3725	Lime, Chalk & Chert
3725 - 3750	Lime & Chalk
3750 - 3756	Lime & Shale
3756 - 3789	Lime
3789 - 3960	Lime & Shale
3960 - 4005	Lime
4005 - 4170	Lime & Shale
4170 - 4323	Lime
4323 - 4425	Lime & Shale
4425 - 4684	Lime
4684 - 4750	Lime & Shale
4750 - 5087	Lime
5087	Rotary Total Depth

RECEIVED  
STATE CORPORATION COMMISSION

MAY 10 1963

CONSERVATION DIVISION  
Wichita, Kansas

D & A

We certify that the above log is true and correct to the best of our knowledge and belief.

CITIES SERVICE OIL COMPANY

BY W. J. Devaney  
 W. J. Devaney  
 District Superintendent