


Give All Information Completely
Make Required Affidavit
Mail or Deliver Report to:
Conservation Division
State Corporation Commission
212 No. Market
Wichita, Kansas

WELL PLUGGING RECORD

NORTH

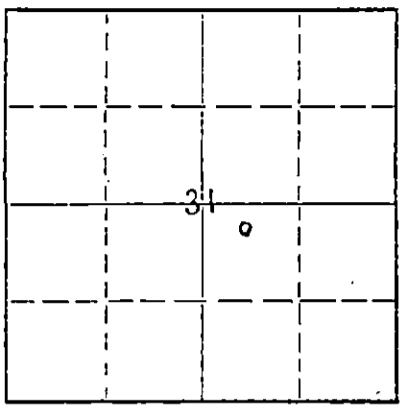

Locate well correctly on above
Section Plat

Kearny County. Sec. 31 Twp. 24S Rge. 36 (E) W (W)
Location as "NE/CNW/SW" or footage from lines 300' N Cen NW SE
Lease Owner Westside Service Corporation
Lease Name John K. Moser Well No. 1
Office Address 1007 Cravens Bldg. Okla. City, Okla. 73102
Character of Well (completed as Oil, Gas or Dry Hole) Dry Hole
Date well completed March 16 1969
Application for plugging filed March 15 1969
Application for plugging approved March 15 1969
Plugging commenced March 16 1969
Plugging completed March 16 1969
Reason for abandonment of well or producing formation Dry

If a producing well is abandoned, date of last production N/A 19__
Was permission obtained from the Conservation Division or its agents before plugging was commenced? Yes

Name of Conservation Agent who supervised plugging of this well Ed Eves - Sublette, Kansas
Producing formation None Depth to top _____ Bottom _____ Total Depth of Well 5124' Feet
Show depth and thickness of all water, oil and gas formations.

OIL, GAS OR WATER RECORDS

CASING RECORD

FORMATION	CONTENT	FROM	TO	SIZE	PUT IN	PULLED OUT
Krider Limestone	Gas	2417'	2434'	8-5/8	1905'	None
	(This is being produced)					
	(in another well in)					
	(Section)					

Describe in detail the manner in which the well was plugged, indicating where the mud fluid was placed and the method or methods used in introducing it into the hole. If cement or other plugs were used, state the character of same and depth placed, from _____ feet to _____ feet for each plug set.

Hole filled with heavy drilling mud from surface to total depth.
35 sacks of cement from 900' to 1000' w/Haliburton Pump
15 sacks 0' to 45' w/Haliburton Pump.

RECEIVED
STATE CORPORATION COMMISSION
MAR 25 1969
CONSERVATION DIVISION
Wichita, Kansas

3-25-1969

(If additional description is necessary, use BACK of this sheet)
Name of Plugging Contractor Service Drilling Co.
Address 406 South Boulder, Tulsa, Oklahoma

STATE OF Oklahoma, COUNTY OF Oklahoma, ss.
Robert A. Northcutt (employee of owner) or ~~(owner or operator)~~ of the above-described well, being first duly sworn on oath, says: That I have knowledge of the facts, statements, and matters herein contained and the log of the above-described well as filed and that the same are true and correct. So help me God.

(Signature) Robert A. Northcutt
1007 Cravens Bldg. Okla. City, Okla.
(Address)

SUBSCRIBED AND SWORN to before me this 24th day of March, 1969

My commission expires November 26, 1972

Joanna Hutchinson
Notary Public.