


WELL PLUGGING RECORD

Give All Information Completely
Make Required Affidavit
Mail or Deliver Report to:
Conservation Division
State Corporation Commission
211 No. Broadway
Wichita, Kansas

T25S NORTH

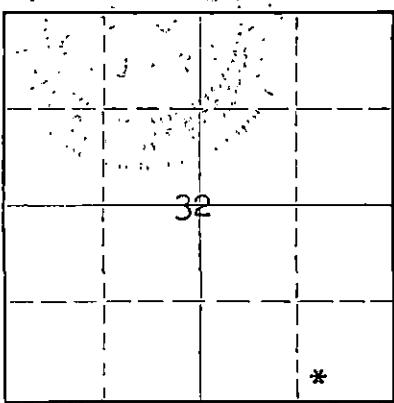

Locate well correctly on above Section Plat

Reno County, Kansas County, Sec. 32 Twp. 25S Rge. 7W (E)____(W)____
Location as "NE/CNWxSWx" or footage from lines SW SE SE
Lease Owner K & E AND OIL TRADING
Lease Name HENDERSON 'B' Well No. 1
Office Address 719 Union Center, Wichita, Kansas
Character of Well (completed as Oil, Gas or Dry Hole) Dry Hole

R	Date well completed	<u>4-16-57</u>	<u>19</u>
7	Application for plugging filed	<u>4-16-57</u>	<u>19</u>
W	Application for plugging approved	<u>4-16-57</u>	<u>19</u>
	Plugging commenced	<u>4-16-57</u>	<u>19</u>
	Plugging completed	<u>4-16-57</u>	<u>19</u>

Reason for abandonment of well or producing formation _____

If a producing well is abandoned, date of last production _____ 19____

Was permission obtained from the Conservation Division or its agents before plugging was commenced? yes

Name of Conservation Agent who supervised plugging of this well Ruel Durkee, McPherson, Kansas
Producing formation _____ Depth to top _____ Bottom _____ Total Depth of Well 4303 Feet
Show depth and thickness of all water, oil and gas formations.

OIL, GAS OR WATER RECORDS

CASING RECORD

FORMATION	CONTENT	FROM	TO	SIZE	PUT IN	PULLED OUT
				<u>8-5/8</u>	<u>251</u>	<u>none</u>

Describe in detail the manner in which the well was plugged, indicating where the mud fluid was placed and the method or methods used in introducing it into the hole. If cement or other plugs were used, state the character of same and depth placed, from _____ feet to _____ feet for each plug set.

Pits stirred up and viscosity raised, filled hole with heavy mud to 250' set solid bridge, mixed 15 sx cement thru 8 joints, filled hole with heavy mud to 30' set solid bridge & mixed 5 sx cement. Plugging Complete.

(If additional description is necessary, use BACK of this sheet)

Name of Plugging Contractor K & E DRILLING, INC.
Address 719 Union Center, Wichita 2, Kansas

STATE OF KANSAS, COUNTY OF Sedgwick, ss.
Dale Silcott (employee of owner) or (owner or operator) of the above-described well, being first duly sworn on oath; says: That I have knowledge of the facts, statements, and matters herein contained and the log of the above-described well as filed and that the same are true and correct. So help me God.

(Signature) Dale Silcott
Dale Silcott, of K & E DRILLING, INC.
719 Union Center, Wichita 2, Kansas (Address)



SUBSCRIBED AND SWORN to before me this 19th day of April 19 57.

My commission expires 11 August 1958.

Patricia M. Edwards, Notary Public.

APR 26 1957

CONSERVATION DIVISION
Wichita, Kansas

PLUGGING
FILE SEC. 32 TWP. 25 RGE. 7W
BOOK PAGE 7 LINE 9

4-26-57

W E L L L O G

OPERATOR: K & E DRILLING, & OILTRADING FARM NAME: #1 HENDERSON 'B'
 719 Union Center Building
 Wichita 2, Kansas
 LOCATION: SW SE SE
 Sec. 32-25S-7W
 Reno County, Kansas
 CONTRACTOR: K & E DRILLING, INC.
 719 Union Center Building
 Wichita 2, Kansas
 COMMENCE: 4-1-57
 COMPLETE: 4-16-57
 CASING RECORD: 8-5/8" @ 251' (160 sx)
 PRODUCTION: D & AA
 R.T.D. 4303' ELEVATION: 1571' KB

FORMATION RECORD

Depths shown indicate bottom of formations

Brown & Blue Shale	249
Shale	680
Salty Shale	805
Shale & Shells	1065
Lime	1505
Lime & Shale	1580
Lime	1750
Lime & Shale	2050
Shale & Lime	2770
Lime & Shale	2875
Lime	2898
Shale	2930
Lime	2975
Shale & Shells	3120
Shale & Lime	3170
Lime	3585
Shale & Lime	3655
Lime & Shale	3795
Shale	3819
Mississippi Chert	3900
Lime & Shale	3930
Lime	3960
Shale	4075
Shale & Lime	4185
Lime & Shale	4225
Sand & Shale	4284
Arbuckle Lime	4303

R.T.D.

RECEIVED 4303
 STATE CORPORATION COMMISSION

APR 26 1957

4-26-57

CERTIFICATION
 CONSERVATION DIVISION
 Wichita, Kansas

STATE OF KANSAS }
 COUNTY OF SEDGWICK } SS:

I, Dale Silcott of the K & E DRILLING, INC., upon oath, state that the above and foregoing is a true and correct copy of the Driller's Log of the #1 HENDERSON 'B' well.

Dale Silcott
 Dale Silcott

Subscribed and sworn to before me this 19th day of April, 1957.

Patricia M. Edwards
 Patricia M. Edwards, Notary Public

My commission Expires: 11 August 1958.

PLUGGING
 FILE SEC. 32 T. 25 S. 7W
 BOOK PAGE 7 LINE 9