

WELL PLUGGING RECORD

STATE OF KANSAS STATE CORPORATION COMMISSION

FORMATION PLUGGING RECORD

Give All Information Completely Make Required Affidavit Mail or Deliver Report to: Conservation Division State Corporation Commission 800 Bitting Building Wichita, Kansas

Strike out upper line when reporting plugging off formations.

Reno County, Sec. 15 Twp. 25 Rge. (E) 5 (W) Location as "NE 1/4 NW 1/4 SW 1/4" or footage from lines SW 1/2 NE 1/2 SW 1/2 Lease Owner J. E. Bauer Lease Name Tonn Well No. 1 Office Address 511 American Nat'l Bank Bldg., Vincennes, Indiana Character of Well (completed as Oil, Gas or Dry Hole) Dry Hole Date well completed August 15 1948 Application for plugging filed August 15 1948 Application for plugging approved August 15 1948 Plugging commenced August 15 1948 Plugging completed August 15 1948 Reason for abandonment of well or producing formation Dry Hole

Section Plat grid with 4 columns and 4 rows, labeled NORTH.

Locate well correctly on above Section Plat

If a producing well is abandoned, date of last production - 19 Was permission obtained from the Conservation Division or its agents before plugging was commenced? Yes

Name of Conservation Agent who supervised plugging of this well Ruel Durkee Producing formation Depth to top Bottom Total Depth of Well 4103 Feet Show depth and thickness of all water, oil and gas formations.

OIL, GAS OR WATER RECORDS CASING RECORD

Table with 7 columns: Formation, Content, From, To, Size, Put In, Pulled Out. Row 1: Surface Pipe, 10 3/4", 190, None.

Describe in detail the manner in which the well was plugged, indicating where the mud fluid was placed and the method or methods used in introducing it into the hold. If cement or other plugs were used, state the character of same and depth placed, from feet to feet for each plug set.

Filled hole with heavy mud from 4103 feet to 185 feet. Set plug at 185 feet and filled with cement to 145 feet. Filled surface casing with heavy mud from 145 feet to 20 feet. Set plug at 20 feet and filled casing with cement to bottom of the cellar.

(If additional description is necessary, use BACK of this sheet)


Correspondence regarding this well should be addressed to J. E. Bauer Address c/o Barnett Drilling, Inc., Wichita, Kansas

STATE OF Kansas, COUNTY OF Sedgwick, ss. R. Steinhorst (employee of owner) or (owner or operator) of the above-described well, being first duly sworn on oath, says: That I have knowledge of the facts, statements, and matters herein contained and the log of the above-described well as filed and that the same are true and correct. So help me God.

(Signature) R. Steinhorst (Address) 9-1-48

SUBSCRIBED AND SWORN to before me this 18th day of August 1948 Adelaide [Signature] Notary Public

My commission expires May 12, 1951

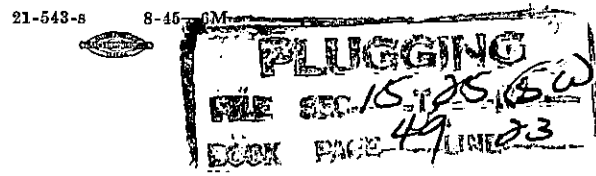

J. E. BAUER
 LOG OF TOWN WELL NO. 1
 SW $\frac{1}{4}$ NE $\frac{1}{4}$ SW $\frac{1}{4}$ SECTION 15-25S-5W, RENO COUNTY, KANSAS.

Formation	From	To	Remarks
Gumbo and Red Bed	0	80	
Red Bed	80	90	
Shale and Lime	90	190	Set 10 3/4" Surface Pipe at 190 feet; Cemented with 100 Sacks of Cement.
Blue and Gray Shale	190	400	
Shale	400	430	
Shale and Shells	430	760	
Anhydrite	760	830	
Lime and Salt	830	895	
Shale and Shells	895	1175	
Lime and Shale	1175	1345	
Shale and Shells	1345	1680	
Salt, Lime and Shale	1680	1875	
Lime and Shale	1875	2140	
Shale and Lime	2140	2335	
Lime and Shale	2335	2415	
Lime	2415	2595	
Lime - Sharp	2595	2618	
Sand	2618	2700	
Shale	2700	2745	
Sand	2745	2750	
Sand, Lime and Shale	2750	2802	
Lime	2802	2906	
Lime and Shale	2906	2941	
Sandy Lime	2941	2980	
Lime	2980	2990	
Lime, Shale and Chert	2990	3035	
Lime and Shale	3035	3070	
Lime	3070	3100	
Shale	3100	3130	
Lime	3130	3235	
Lime and Shale	3235	3350	
Lime and Shale - Sticky	3350	3385	
Lime and Shale	3385	3415	
Shale and Lime	3415	3460	
Shale	3460	3535	
Lime - Cherty	3535	3550	
Lime and Shale	3550	3595	
Chat	3595	3605	
Lime - Cherty	3605	3635	
Chat	3635	3660	
Lime - Chat	3660	3685	
Lime, Chert and Shale	3685	3710	
Lime	3710	3740	
Lime and Shale	3740	3770	
Shale	3770	3795	
Lime and Shale	3795	3835	
Shale, Sand and Lime	3835	3890	
Shale and Sand	3890	3905	
Shale	3905	3940	
Shale and Lime	3940	3960	
Lime and Sand	3960	3990	
Shale and Sand	3990	4010	
Shale and Lime	4010	4035	
Shale and Sand	4035	4050	
Lime	4050	4103	
Total Depth		4103	Dry and Abandoned.

9-1-48

PLUGGING
 FILE SEC 15-25S-5W
 BOOK PAGE 49 LINE 83

