


STATE OF KANSAS STATE CORPORATION COMMISSION

Give All Information Completely Make Required Affidavit Mail or Deliver Report to: Conservation Division State Corporation Commission 211 No. Broadway Wichita, Kansas

WELL PLUGGING RECORD

STAFFORD County. Sec. 33 Twp. 25s Rge. 14w (X) (W)

Location as "NE/CNW/SW" or footage from lines NW SW SW
Lease Owner PETROLEUM, INC.
Lease Name VAN WINKLE "D" #1 Well No. 1
Office Address ROUTE #2, GREAT BEND, KANSAS
Character of Well (completed as Oil, Gas or Dry Hole) DRY HOLE
Date well completed 11-25- 19 63
Application for plugging filed 11-25- 19 63
Application for plugging approved 11-25- 19 63
Plugging commenced 11-25- 19 63
Plugging completed 11-25- 19 63
Reason for abandonment of well or producing formation NO PRODUCIBLE ZONES

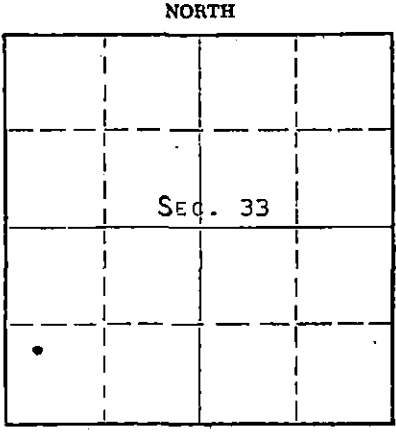

Locate well correctly on above Section Plat

If a producing well is abandoned, date of last production 19
Was permission obtained from the Conservation Division or its agents before plugging was commenced? YES

Name of Conservation Agent who supervised plugging of this well A. ELVING
Producing formation - Depth to top - Bottom - Total Depth of Well 4120 Feet
Show depth and thickness of all water, oil and gas formations.

OIL, GAS OR WATER RECORDS

CASING RECORD

Table with 7 columns: FORMATION, CONTENT, FROM, TO, SIZE, PUT IN, PULLED OUT. Row 1: SIZE 8-5/8, PUT IN 355, PULLED OUT 355'

Describe in detail the manner in which the well was plugged, indicating where the mud fluid was placed and the method or methods used in introducing it into the hole. If cement or other plugs were used, state the character of same and depth placed, from feet to feet for each plug set.

MUDDED UP WITH HEAVY MUD TO 300', FOLLOWED BY A WOODEN PLUG & 25 SACKS CEMENT, 1/4 SACK HULLS. MUDDED UP WITH HEAVY MUD TO 40', FOLLOWED BY 1/4 SACK HULLS. PLACED 10 SACKS CEMENT ON TOP OF HULLS TO BASE OF WELL CELLAR.

RECEIVED STATE CORPORATION COMMISSION

DEC 9 1963

12-9-63

CONSERVATION DIVISION Wichita, Kansas

(If additional description is necessary, use BACK of this sheet)

Name of Plugging Contractor GARVEY DRILLING CO.
Address R. R. #2, GREAT BEND, KANSAS

STATE OF KANSAS, COUNTY OF BARTON, ss. MONTE CHADD (employee of owner) or (owner/representative) of the above-described well, being first duly sworn on oath, says: That I have knowledge of the facts, statements, and matters herein contained and the log of the above-described well as filed and that the same are true and correct. So help me God. MONTE CHADD, DIST. PROD. SUPT. (Signature)

(Address)

SUBSCRIBED AND SWORN TO before me this 6TH day of DECEMBER, 19 63

My commission expires SEPTEMBER 23, 1967

Notary Public signature

WELL LOG

15-185-30403-0000

COMPANY Petroleum, Inc.

SEC. 33 T. 25S R. 14W

FARM Van Winkle

NO. D-1

LOC. NW SW SW


TOTAL DEPTH 4120'

COUNTY Stafford

COMM. 11-14-63

COMP. 11-25-63

CONTRACTOR Garvey Drilling Company

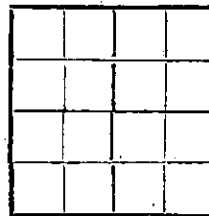

CASING 8 5/8" @ 355' w/350 SX

ELEVATION 2003 D.F.

PRODUCTION D & A

FIGURES INDICATE BOTTOM OF FORMATIONS

- 20' Sand and Clay
- 40' Clay
- 265' Sand
- 355' Red Bed
- 1400' Shale and Red Bed
- 1930' Shale and Shells
- 2268' Lime
- 2455' Shale and Lime
- 2570' Lime
- 2790' Lime and Shale
- 3630' Shale and Lime
- 3805' Lime and Shale
- ~~XXXX'~~ ~~XXXX~~
- 4120' Lime
- 4120' RTD

RECEIVED
STATE CORPORATION COMMISSION

DEC 9 1963
12-9-63
CONSERVATION DIVISION
Wichita, Kansas

State of Kansas } ss

County of Barton }

I, Sam N. Stephens of Garvey Drilling Company

upon oath state the above and foregoing is a true and correct copy of the log of the Van Winkle D-1 well.

Sam N. Stephens

Subscribed and sworn to before me this 3rd day of December 19 63

My Commission Expires: September 23rd, 1967

Edward B. Jones
NOTARY PUBLIC